


T. 6 N. R. 35 E. W.M.

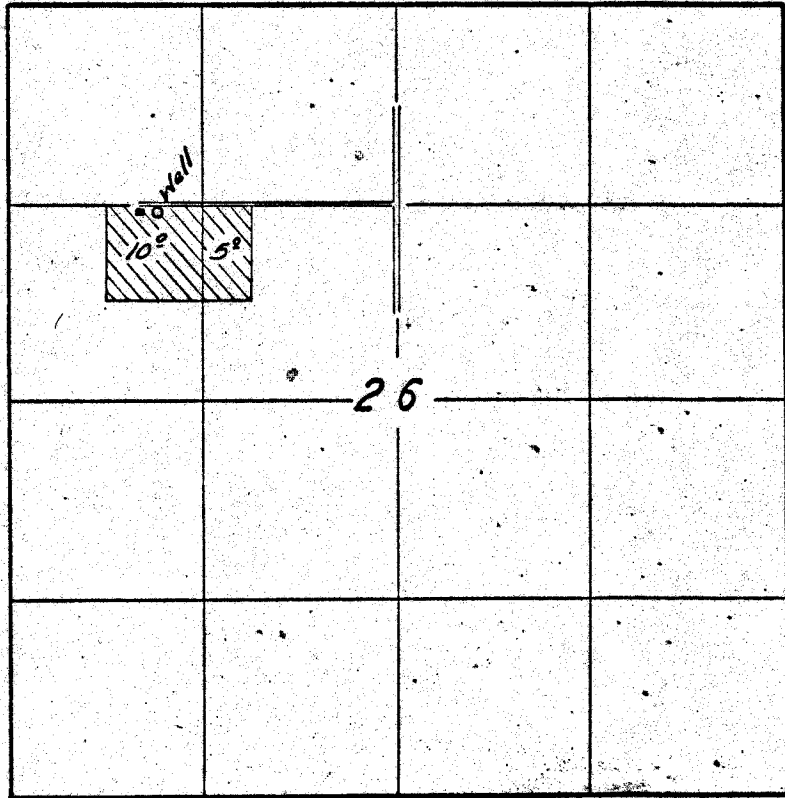

FINAL PROOF SURVEY

UNDER

Application No. G-1066 Permit No. G-1027

IN NAME OF

Melvin F. Nye

Surveyed Oct. 24, 1959, by C. O. Burtis