


T. 5S. R. 1 & 2W. W.M.

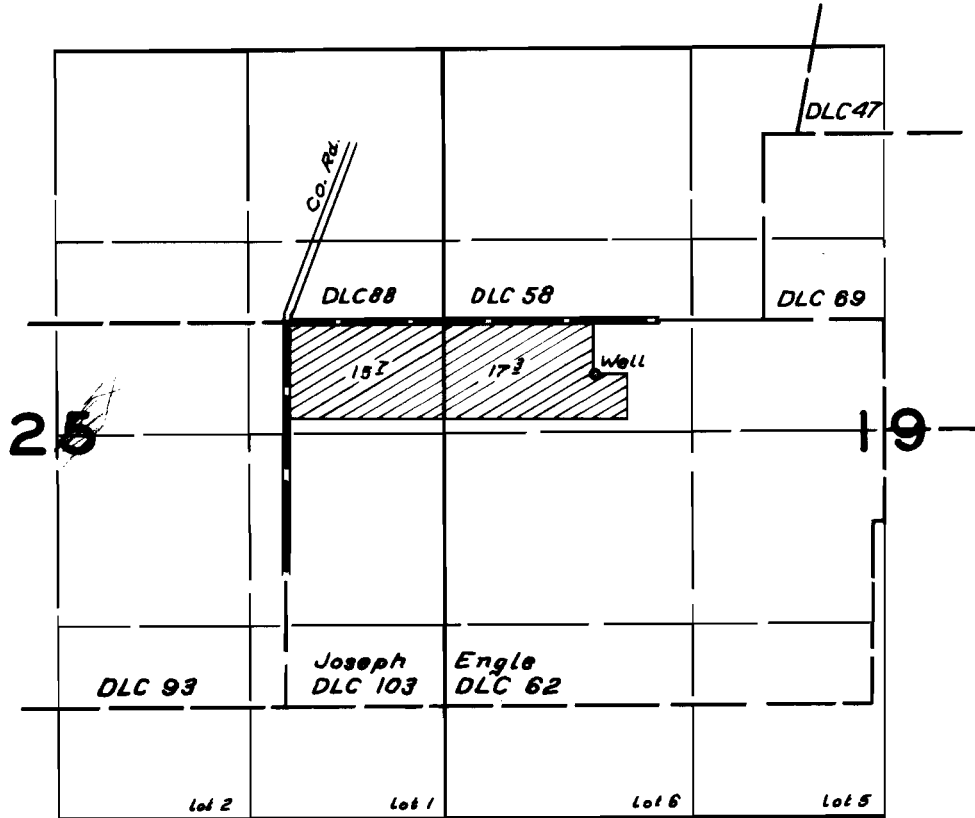

FINAL PROOF SURVEY
UNDER

Application No. *G/244* Permit No. *G/1181*
IN NAME OF

Cornelis Pieter Veldhuisen

Surveyed *April 23 1959* by *R. H. Jackson*