


T.6N. R.35E.W.M.

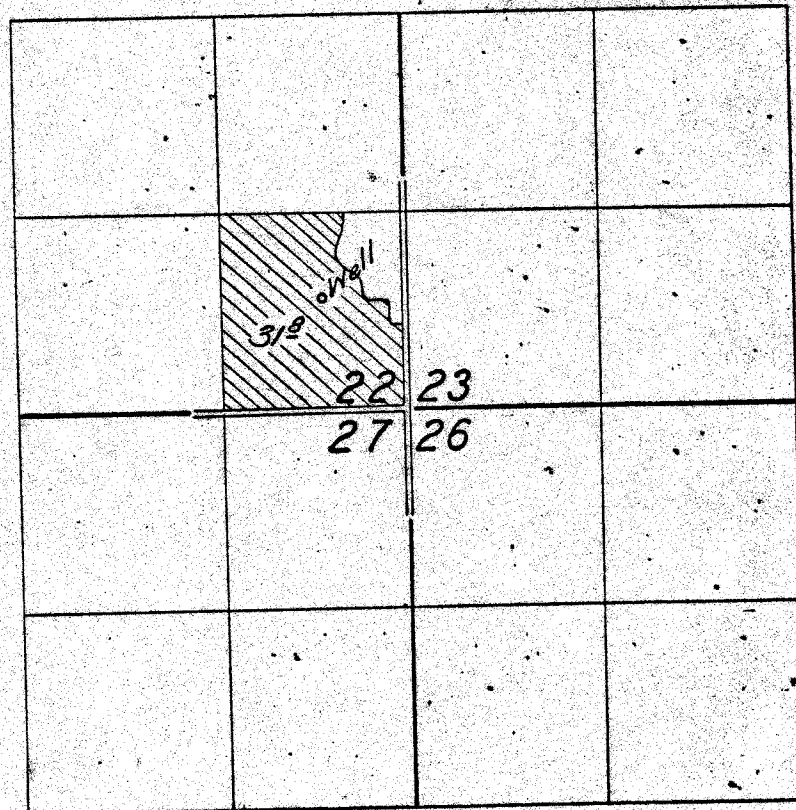

FINAL PROOF SURVEY

UNDER

Application No. G-1400 Permit No. G-1295

IN NAME OF

Gust. Beilke

Surveyed Oct. 23, 1959, by C. O. Beilke