


G-1339
27222

T.6N. R.35E. WM.

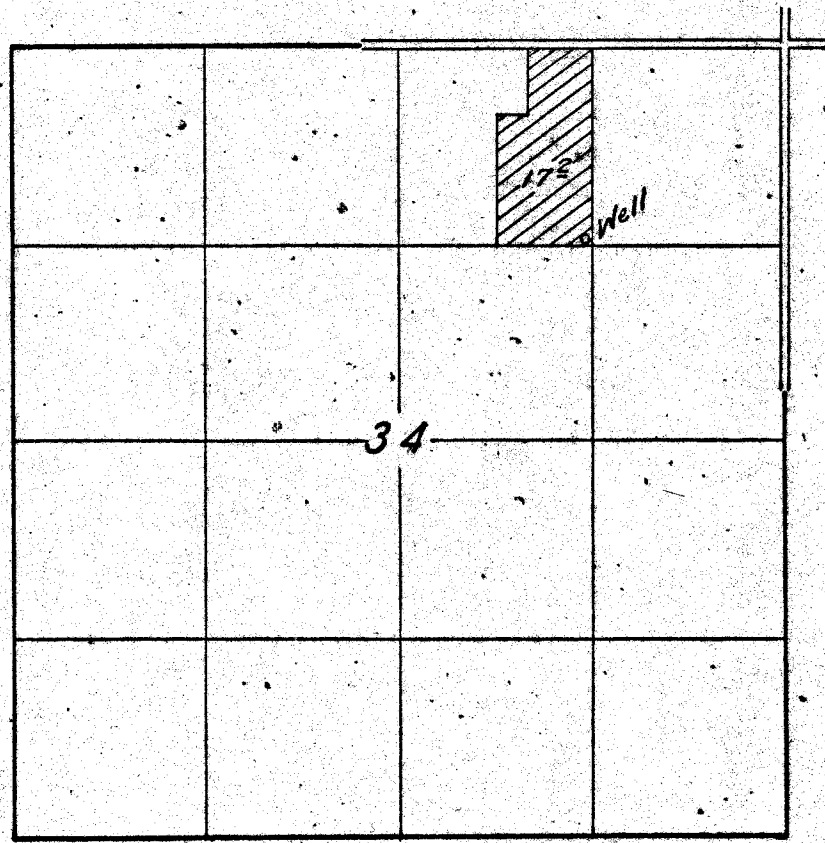

FINAL PROOF SURVEY

UNDER

Application No. ~~G-1455~~ Permit No. G-1339

IN NAME OF

Chris Feigner

Surveyed Oct. 24, 1959, by C.D. Bantala