



T. 3S. R. 1E. W.M.

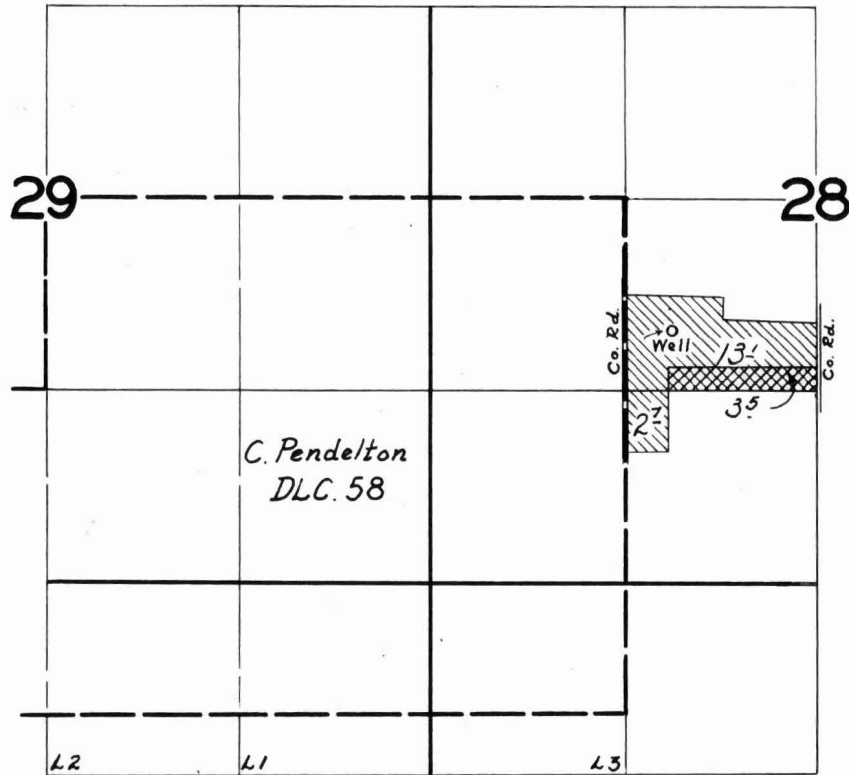

G-699 
G-1576 

FINAL PROOF SURVEY
UNDER

Application No. G-1576 Permit No. G-1437
G-699 G-600
IN NAME OF

Tom & John R. Dodds

Surveyed *Sept. 3* 1959, by *R. H. Jackson*