


T.39 S.R.13 E.W.M.

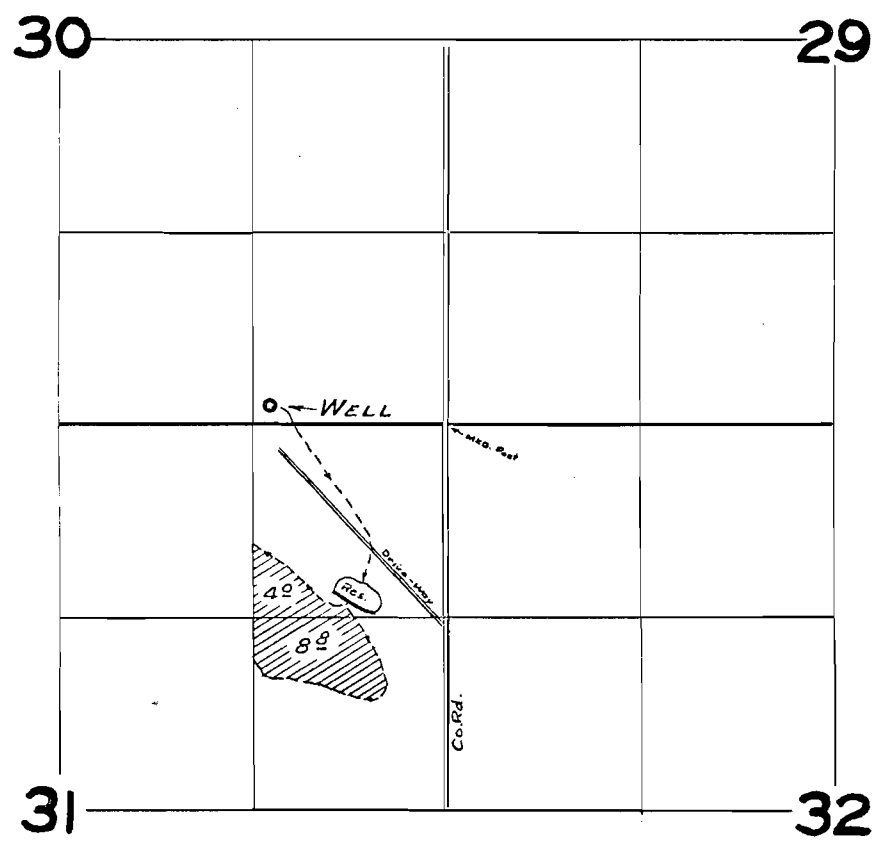

Miller Creek wells

FINAL PROOF SURVEY

UNDER

Application No. U-256 Part of U-228

IN NAME OF

MYREL D. SETTLE

Surveyed Oct. 9, 1959, by M. B. Bish