


U-229
C-27225

T.6N.R.35E.W.M.

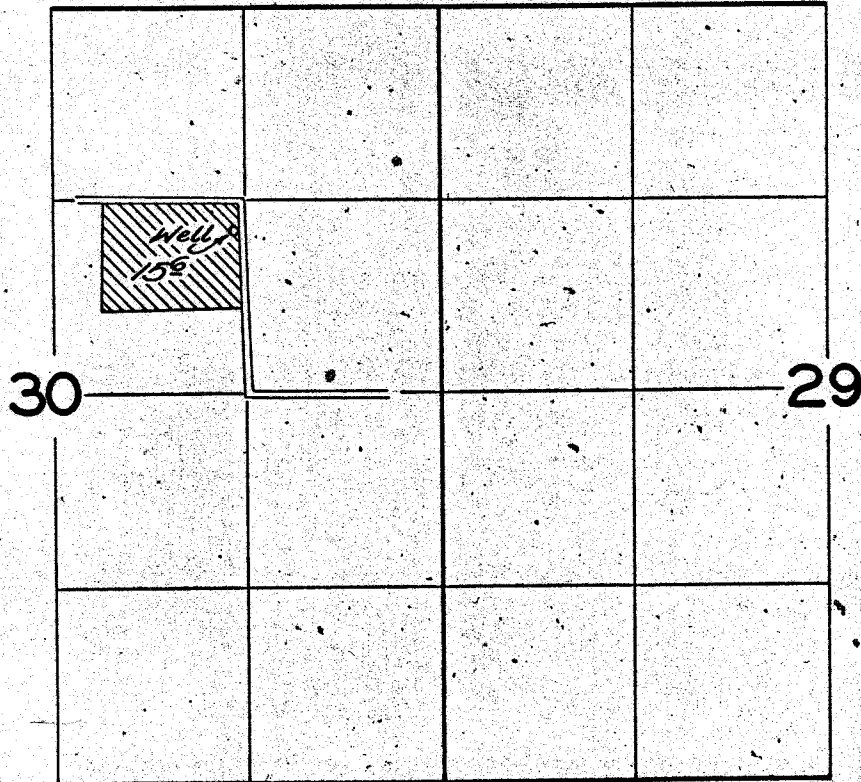

FINAL PROOF SURVEY

UNDER

Application No. U-257 Permit No. U-229

IN NAME OF

P.J. & Josie Kirchgastner

Surveyed Oct. 22, 1959, by C.O. Burtels