


T. 15. R. 38E. W.M.

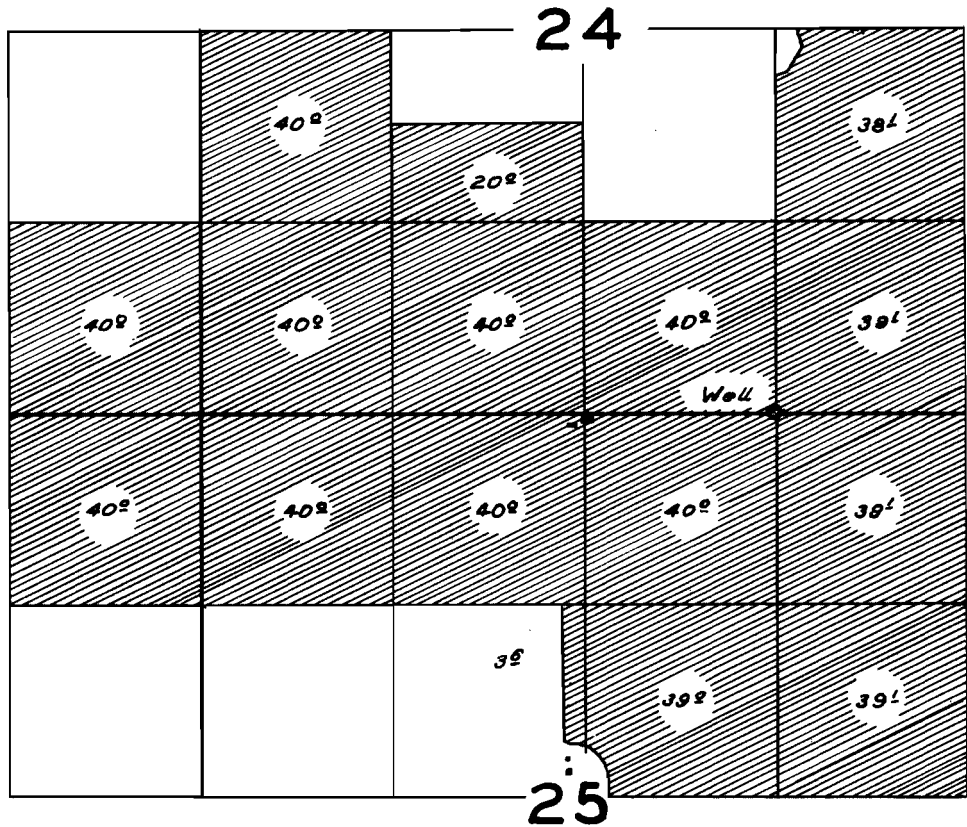

FINAL PROOF SURVEY UNDER

Application No. *U-335* Permit No. *U-309*
IN NAME OF

Marion Wagner

Surveyed *Aug. 4, 1959*, by *R.H. Jackson*