


27228
43773 RR
Red area has been
Cancelled

T.39S.R.11E.W.M.

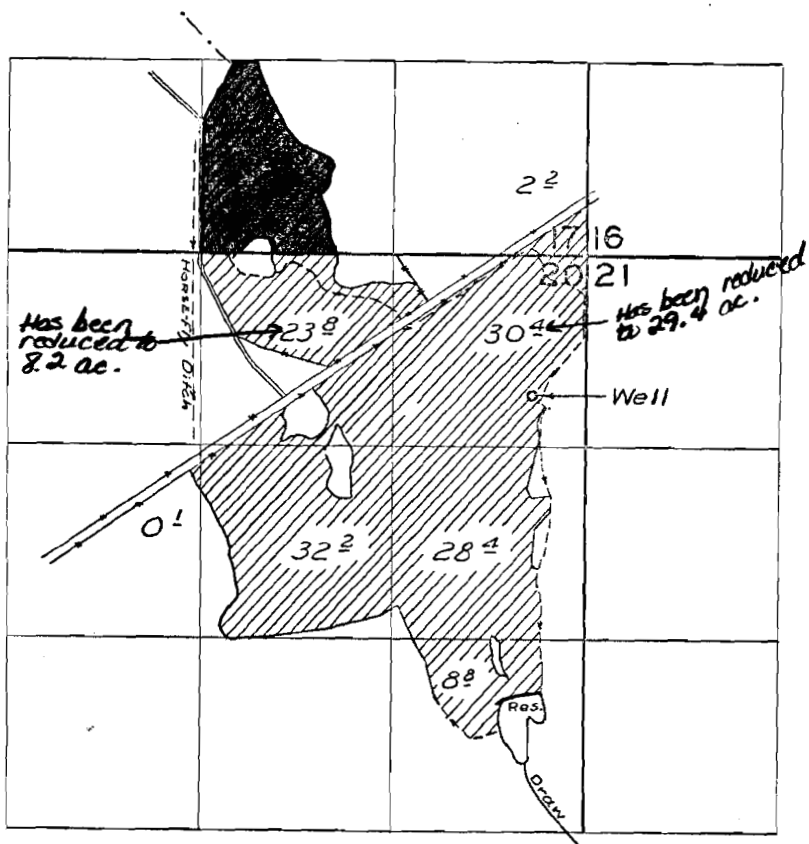

FINAL PROOF SURVEY

UNDER

Application No. U-420 Permit No. U-384

IN NAME OF

HOMER M. HOLT

Surveyed 12 Oct. 1959 by M. Bush