


T.18S.R.46E.W.M.

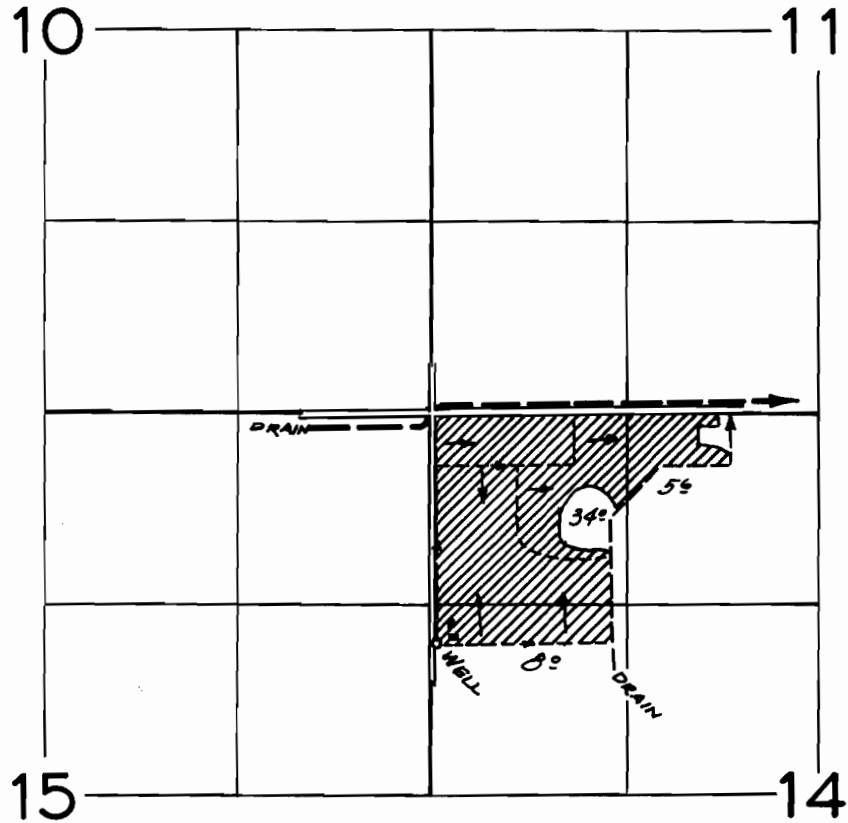

FINAL PROOF SURVEY
UNDER

Application No. U-767... Permit No. U-687.
IN NAME OF

LAWERN & ELLEN KING

Surveyed Sept. 26 1959, by *RH Jackson*