


Sprague River wells

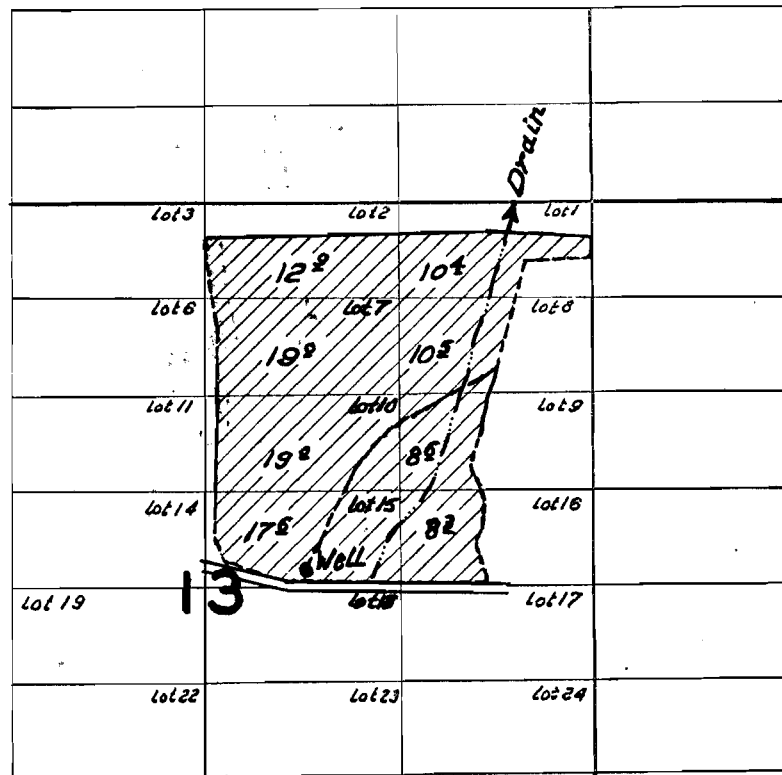

Surveyed Oct. 23, 1959, by R.H. Jackson.....