


T. 1N. R. 10W. W.M.

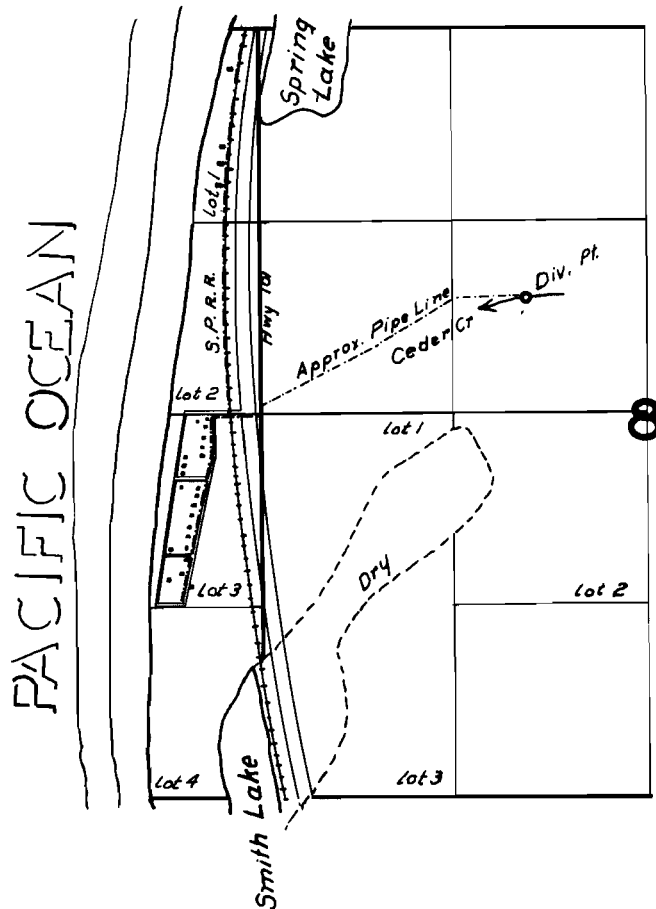

FINAL PROOF SURVEY UNDER

Application No. 19467... Permit No. 15093...
IN NAME OF

..... *P.F., Winona & Paul F. Hatch*

Surveyed *April 15 1959*, by *R.H. Jackson*...
Sept. 9, 1957, by *C.O. Bartels*