



T.12S. R. 9E. W.M.

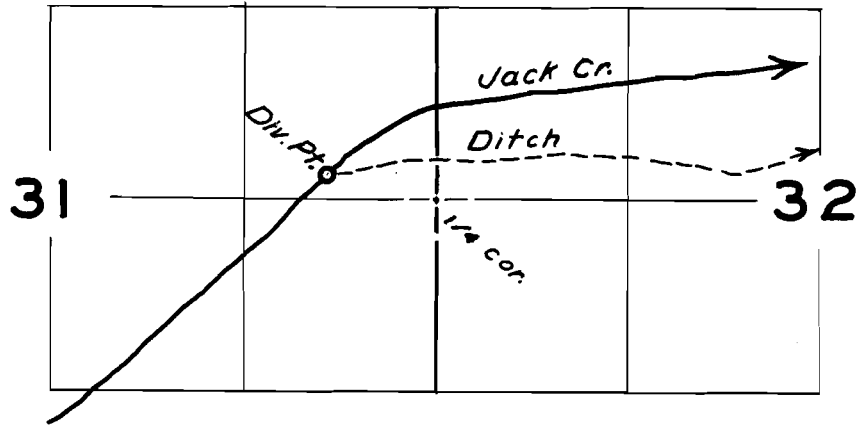

T.12S. R. 9E. W.M.

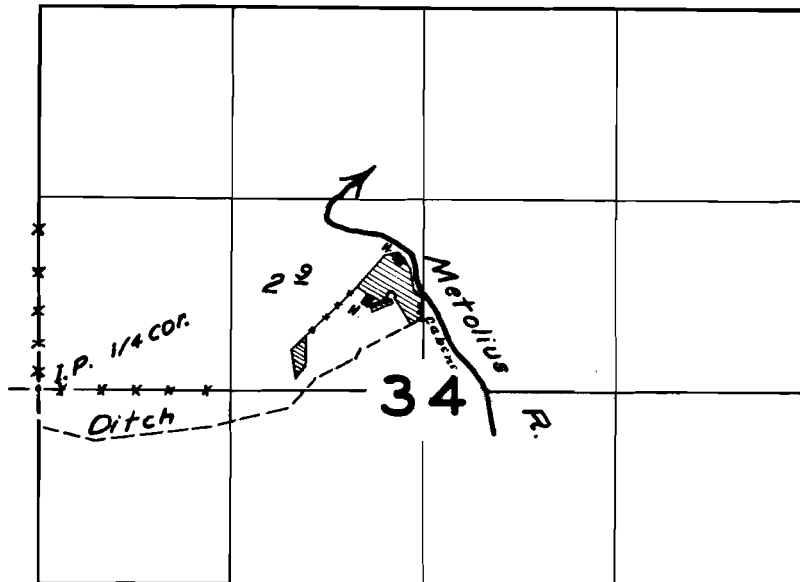

FINAL PROOF SURVEY
UNDER

Application No. 19338 Permit No. 15311
IN NAME OF

John Gallois

Surveyed Oct. 28 1958, by W. N. Perry