


T. 3S. R. 45E. W.M.

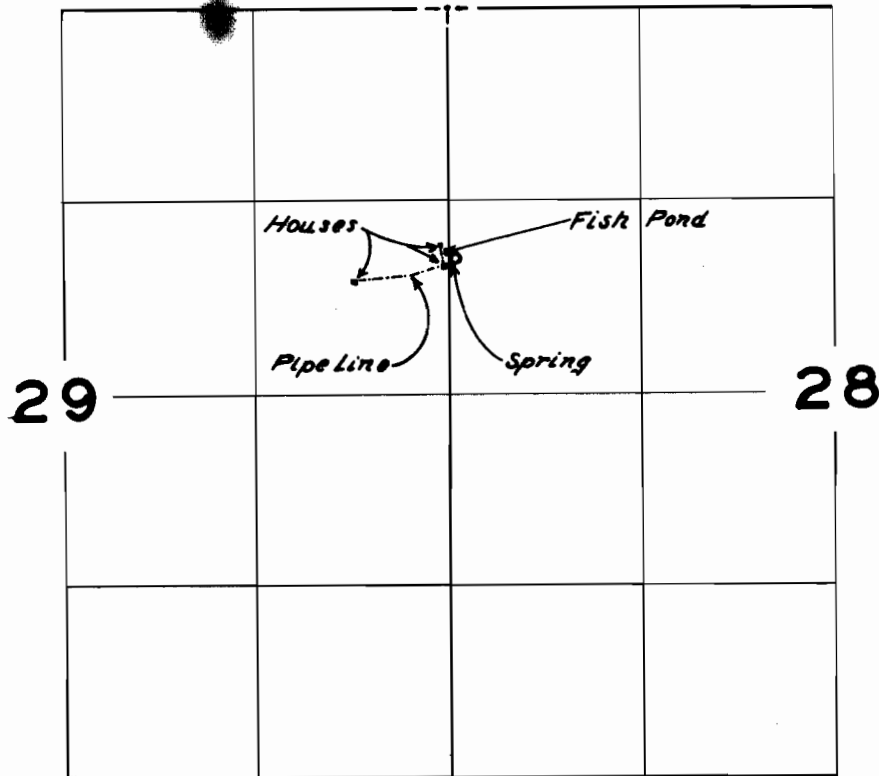

**FINAL PROOF SURVEY**  
UNDER

Application No. 21704 Permit No. 17095  
IN NAME OF

O.W. CASTLE & CHARLOTTE L. WHITAKER

Surveyed AUG. 11 1959, by R.H. JACKSON