


16311

T. IN R. 13 E. W. M.

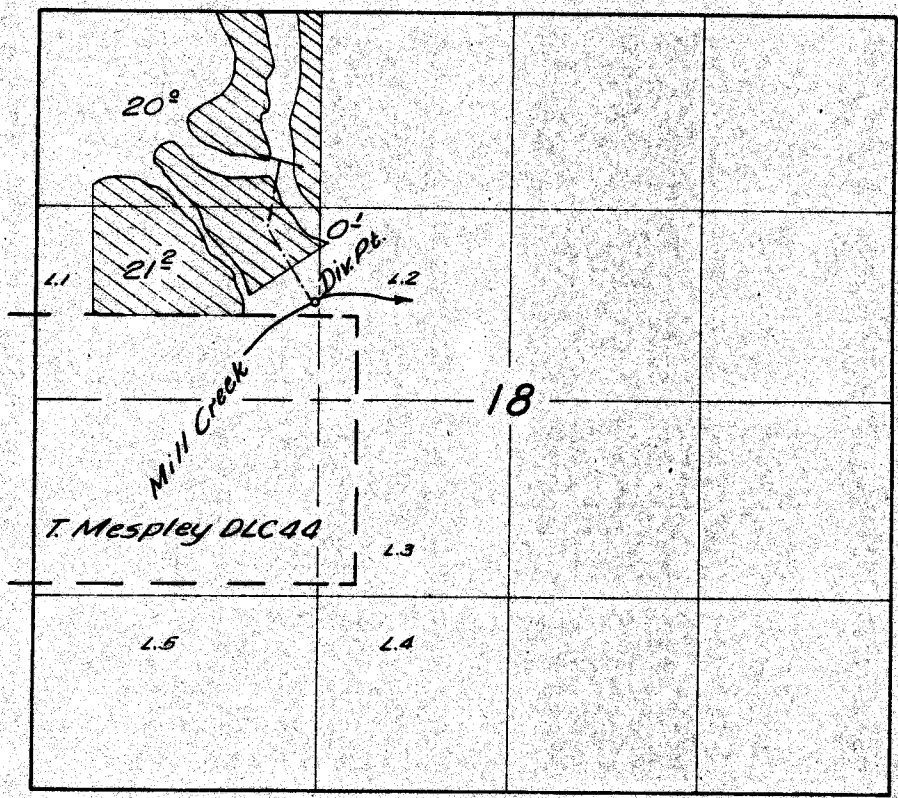

FINAL PROOF SURVEY

UNDER

Application No. 23249 Permit No. 18311

IN NAME OF

Edward C. & June Ransam

Surveyed Nov 19 1959, by C. O. Parfitt