
TIOS. R.5W.W.M.

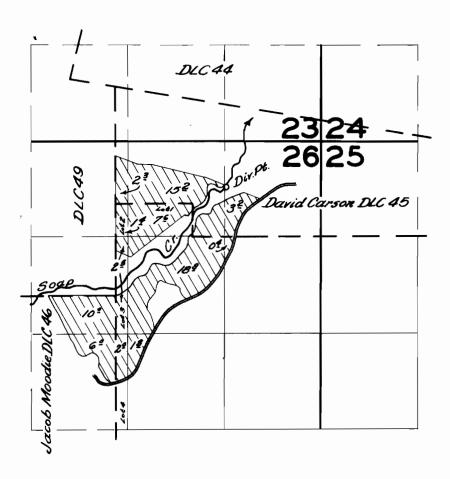

FINAL PROOF SURVEY

Application No. 23/55... Permit No. 18680...IN NAME OF

School of Agriculture of Oregon State College

Surveyed March 20 1959, by C.O. Bacelo......