


T.2S. R. 40E. WM.

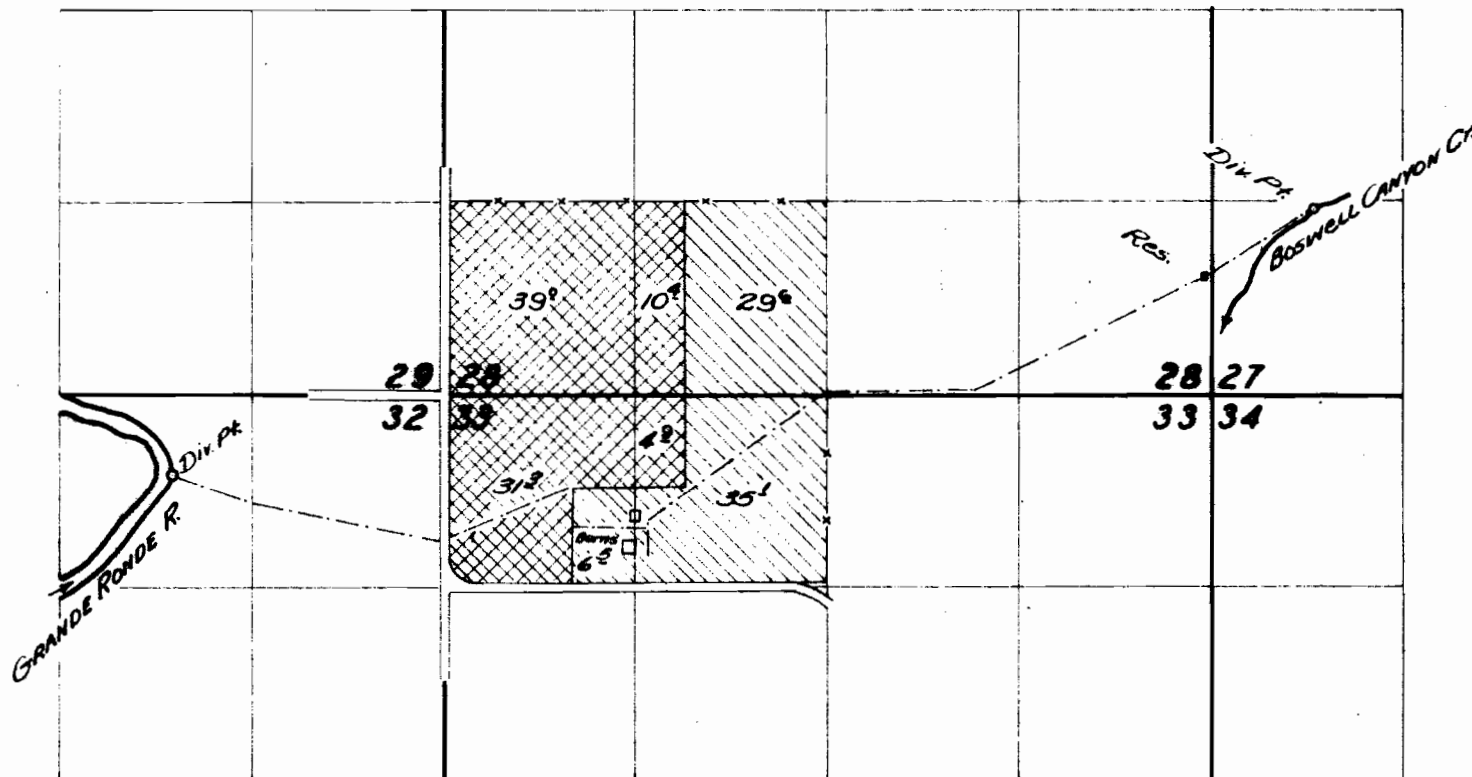

FINAL PROOF SURVEY

UNDER

Application No. *R-24961* Permit No. *R-1025*
24609 *19382*
22493 *22282*

IN NAME OF

HARLOW C. & MELBA HONSTADT

Surveyed *Aug. 13*, 1959., by *C. Q. Hartke*