


T.2S. R.38E.W.M.

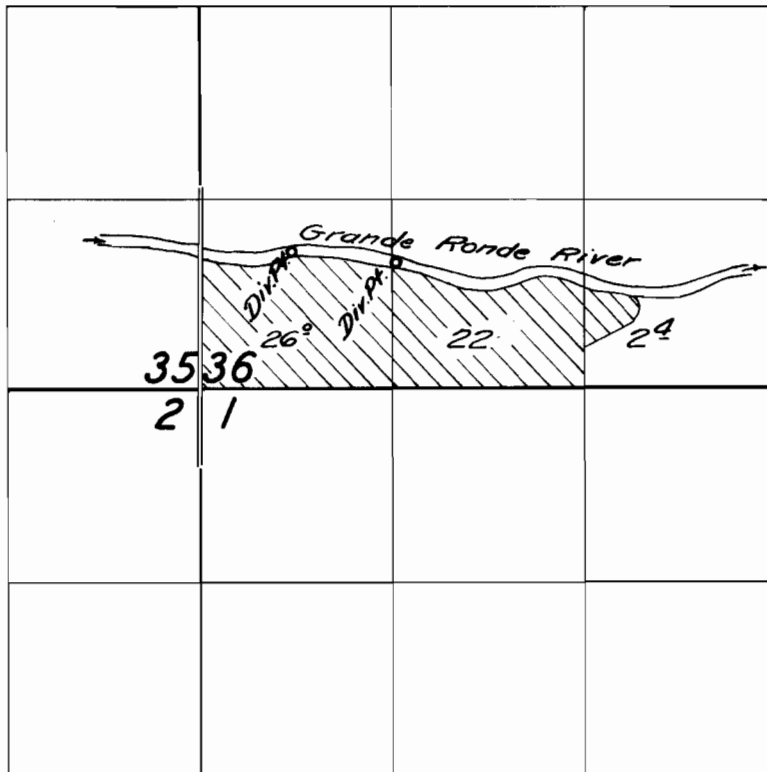

FINAL PROOF SURVEY

UNDER

Application No. 24808 Permit No. 19536

IN NAME OF

Harvey D. Schroeder

Surveyed Aug. 14, 1959 by W. B. Burt