


20946
+ 24611

T.2N.R.13E.W.M.

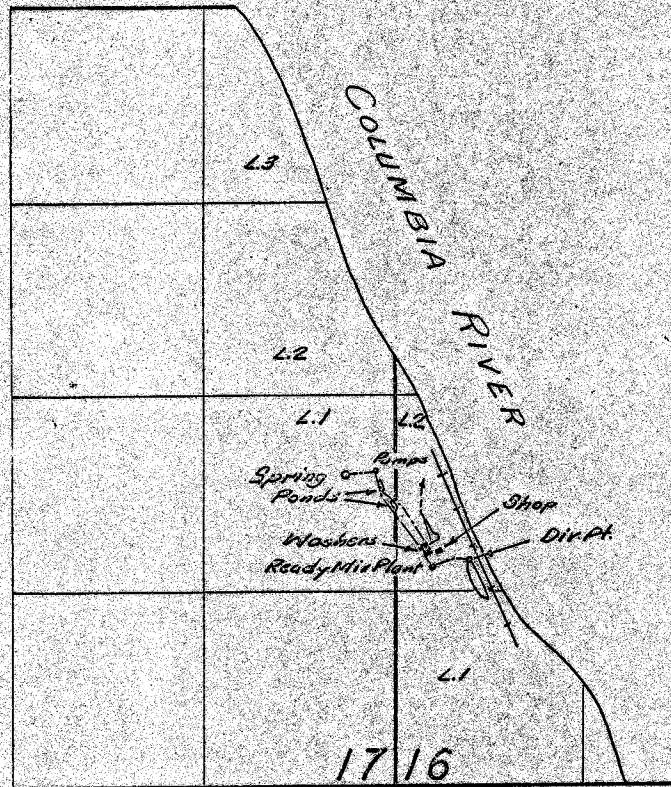

FINAL PROOF SURVEY

UNDER

Application No. 26818 / 31225 Permit No. 20946 / 24611

IN NAME OF

The Dallas Concrete Products Co.

Surveyed Nov. 10, 1959, by C. O. Bartels