


T.6 S.R.13 & 14 E.W.M.

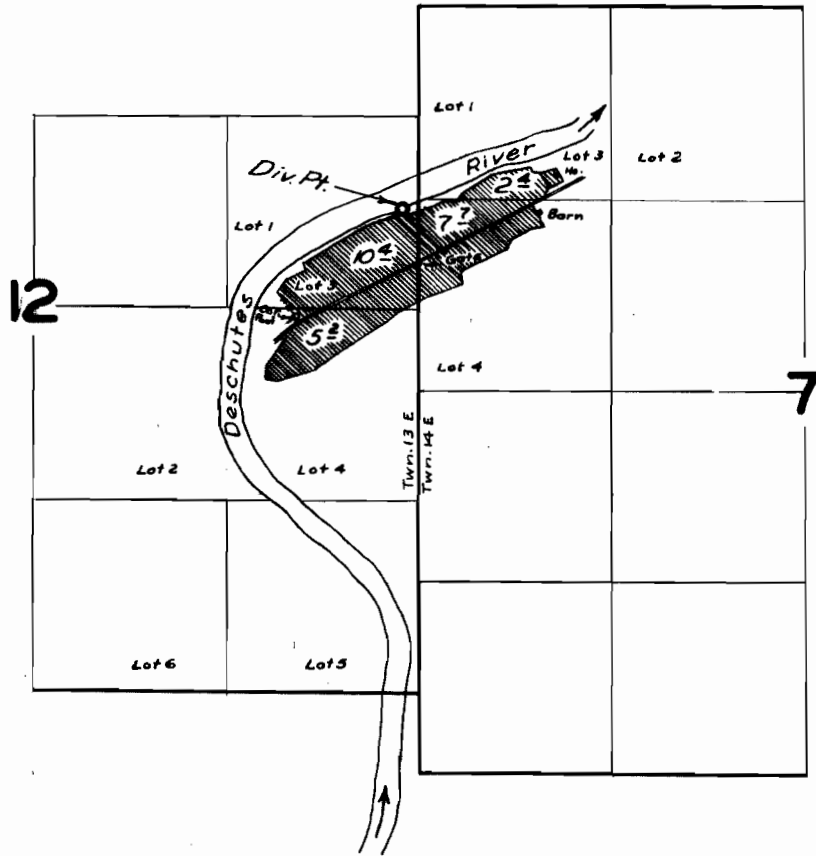

FINAL PROOF SURVEY UNDER

Application No. 26920 Permit No. 20948
IN NAME OF

PORTLAND DESCHUTES CLUB

Surveyed 14 Nov. 1959, by M. Bish