


T.17S. R.6W.W.M.

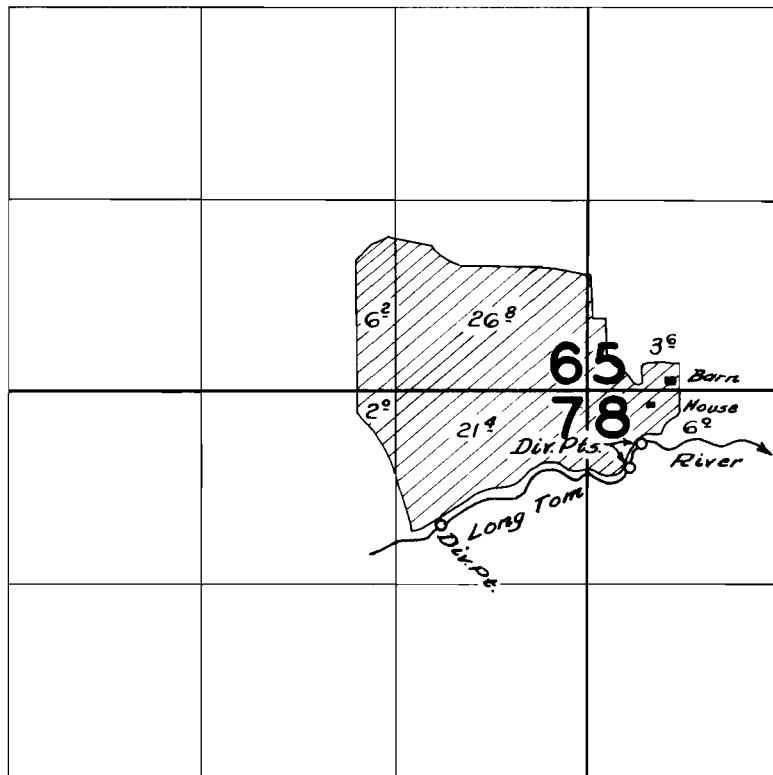

FINAL PROOF SURVEY
UNDER

Application No. *26187* Permit No. *20992*
IN NAME OF

W.G. Buehler

Surveyed *March 26 1959*, by *C.H. Burtch*