


T.13 S.R.5 W.W.M.

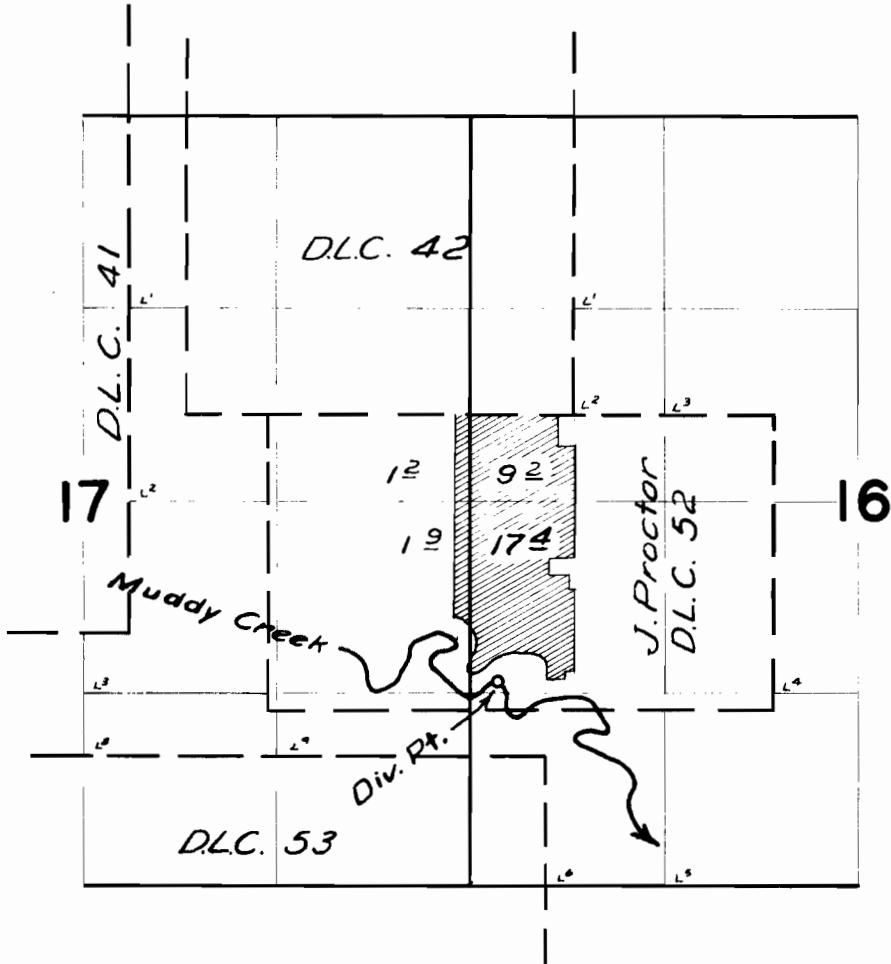

FINAL PROOF SURVEY
UNDER

Application No. 26742 Permit No. 21027
IN NAME OF

CLAUDE BUCHANAN

Surveyed 9 Mar. 1959, by M. Usher