


Per 21516  
27248

# T. 14 S.R. 31 E.W.M.

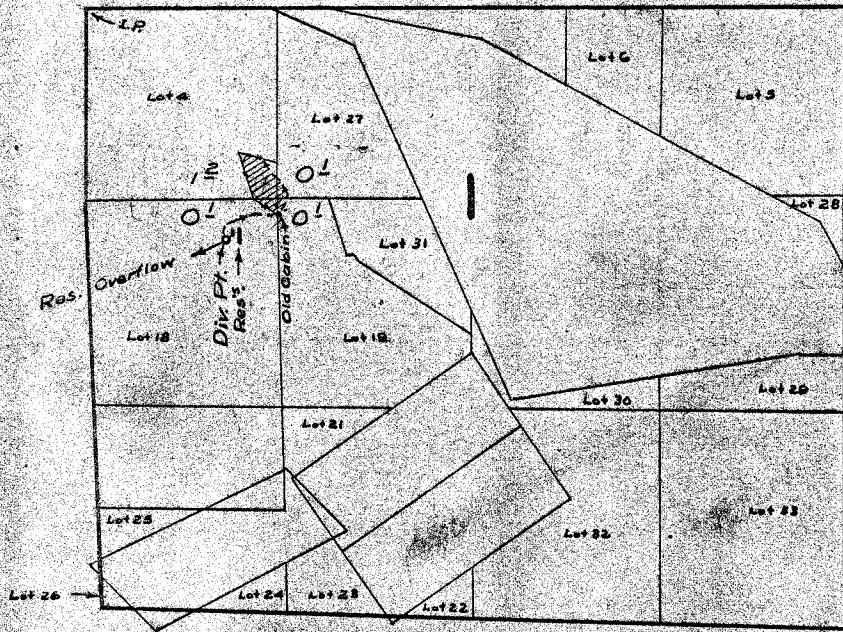

## FINAL PROOF SURVEY

UNDER

Application No. 27052 Permit No. 21516

IN NAME OF

ROY KILPATRICK

Surveyed 18 Sept. 1957, by Wm. Bish