


T. 14 S. R. 5 W. W. M.

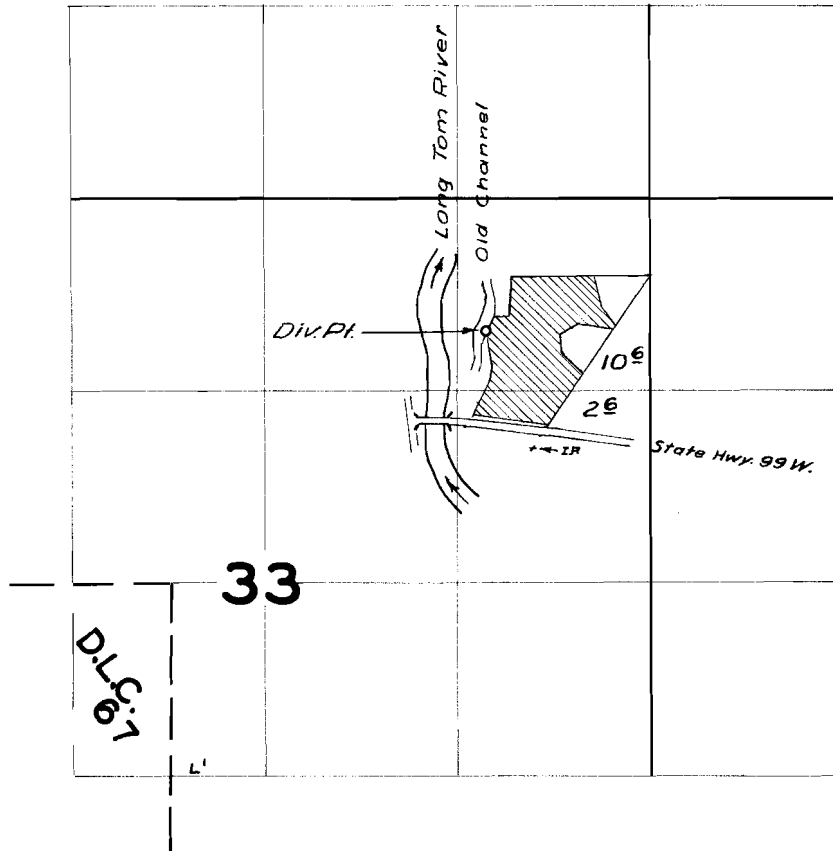

FINAL PROOF SURVEY UNDER

Application No. 27482 Permit No. 21632
IN NAME OF

MONROE FEED STORE

Surveyed Apr. 26 1957, by R. H. Whitby