


T.37 S.R.9 W.W.M.

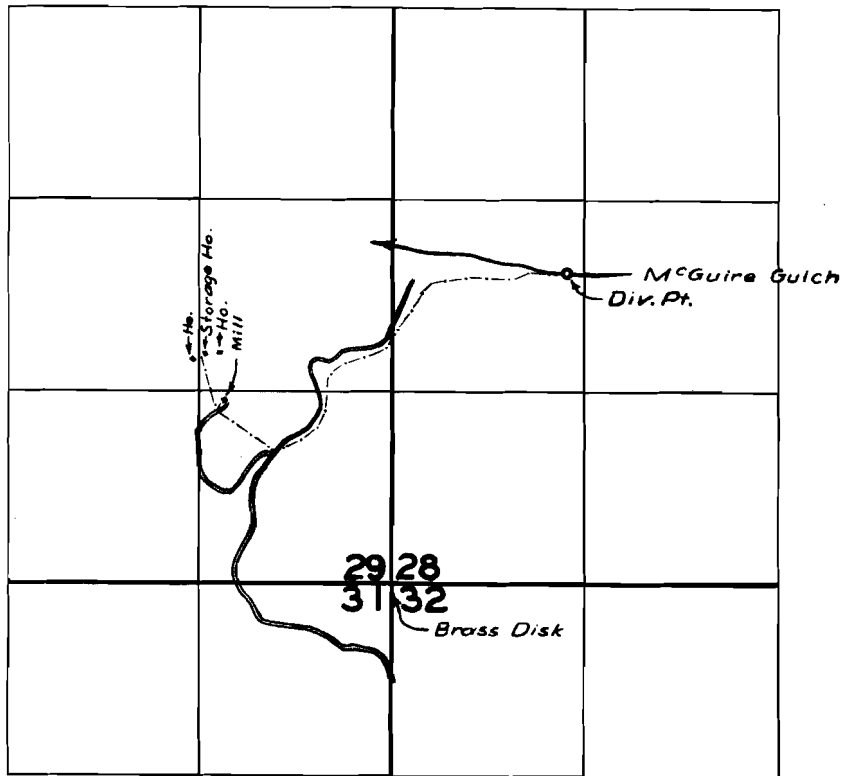

FINAL PROOF SURVEY

UNDER

Application No. 27513 Permit No. 21675
IN NAME OF

ERNEST A. FOSTER

Surveyed 21 July 1959, by Mr. B. S. H.