


T. 2 S. R. 39 E. W. M.

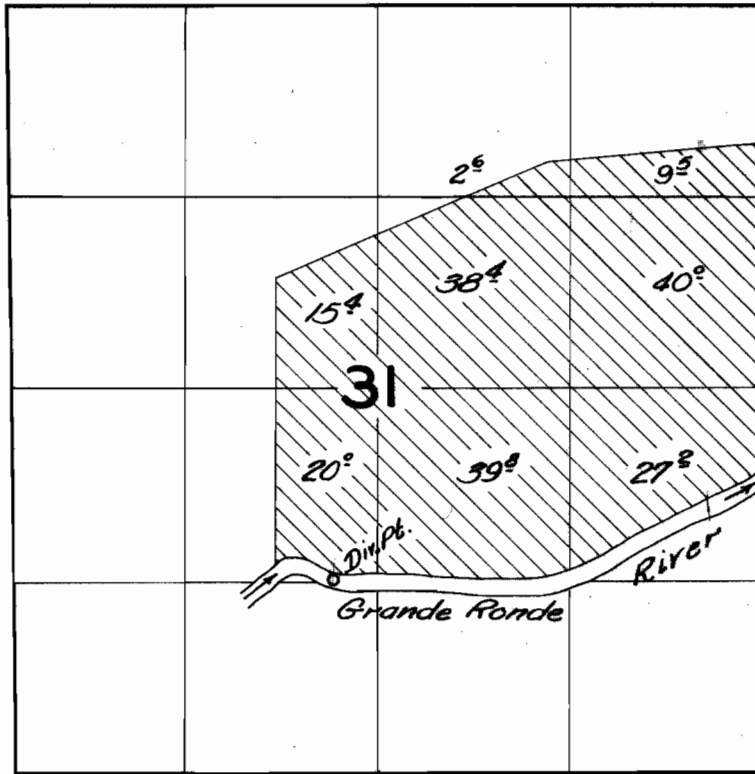

FINAL PROOF SURVEY

UNDER

Application No. 27825.. Permit No. 21886.....

IN NAME OF

Ralph Taggart

Surveyed *Aug. 14* 19 *59*., by *C. O. Bartels*