


T.14 S.R.8W.W.M.

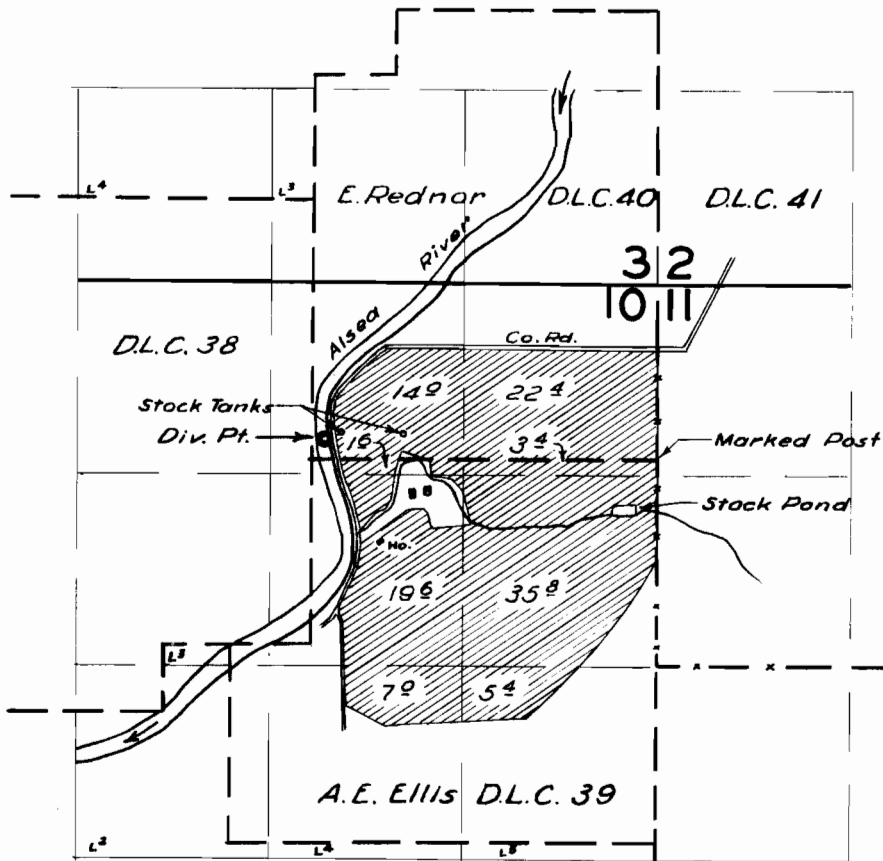

FINAL PROOF SURVEY UNDER

Application No. 27955 Permit No. 22109
IN NAME OF

BERYL O. TOM

Surveyed 17 Mar. 1959, by M. Bish