


T. 2S. R. 1W. WM.

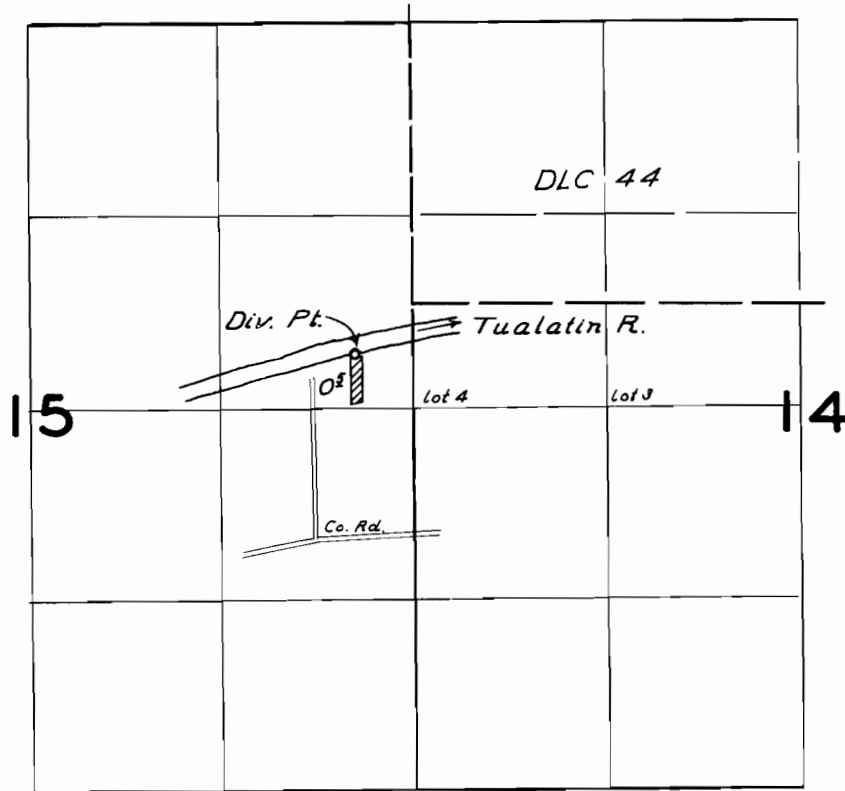

**FINAL PROOF SURVEY**  
UNDER

Application No. 28328 . Permit No. 22361  
IN NAME OF

*Mrs. Emma A. Bousha*

Surveyed *Sept. 14 1959*, by *C.O. Bartels*