


T. 13S. R. 4W. W.M.

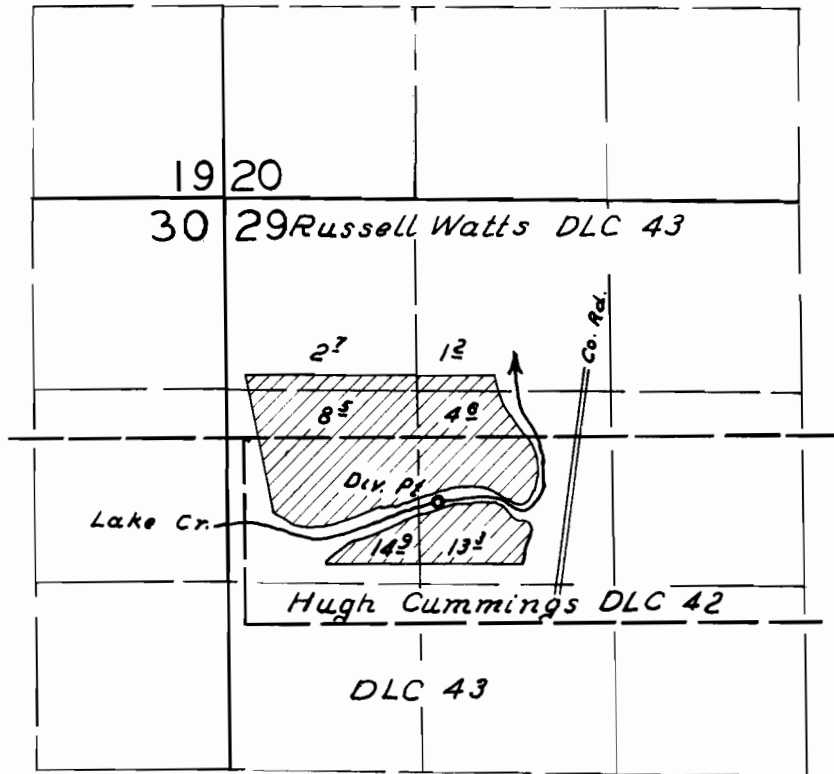

28236

22443

Carl T. Nichols & Hope E. Nichols

Aug. 26 59

R. H. Jackson