


FINAL PROOF SURVEY
 UNDER

Application No. 28502 Permit No. 22522
 IN NAME OF

Roberta Harrison

Surveyed May 27, 1960, by D.C. Hendrix

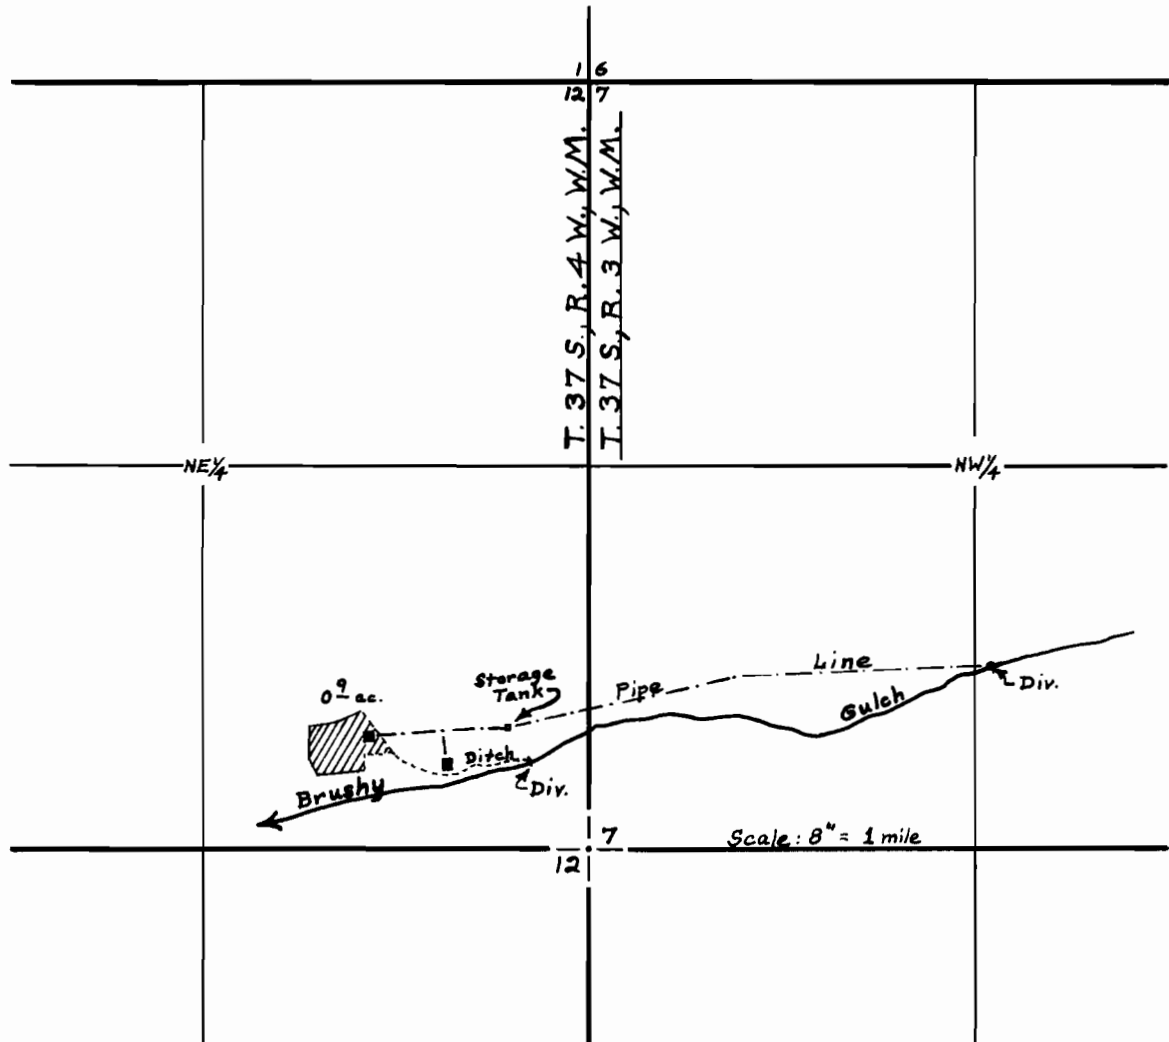

FINAL PROOF SURVEY

UNDER

Application No. 28502 Permit No. 22522

IN NAME OF

Roberta Harrison

Surveyed May 27, 1960, by D.C. Hendrix