


T.13 S.R.5 W.W.M.

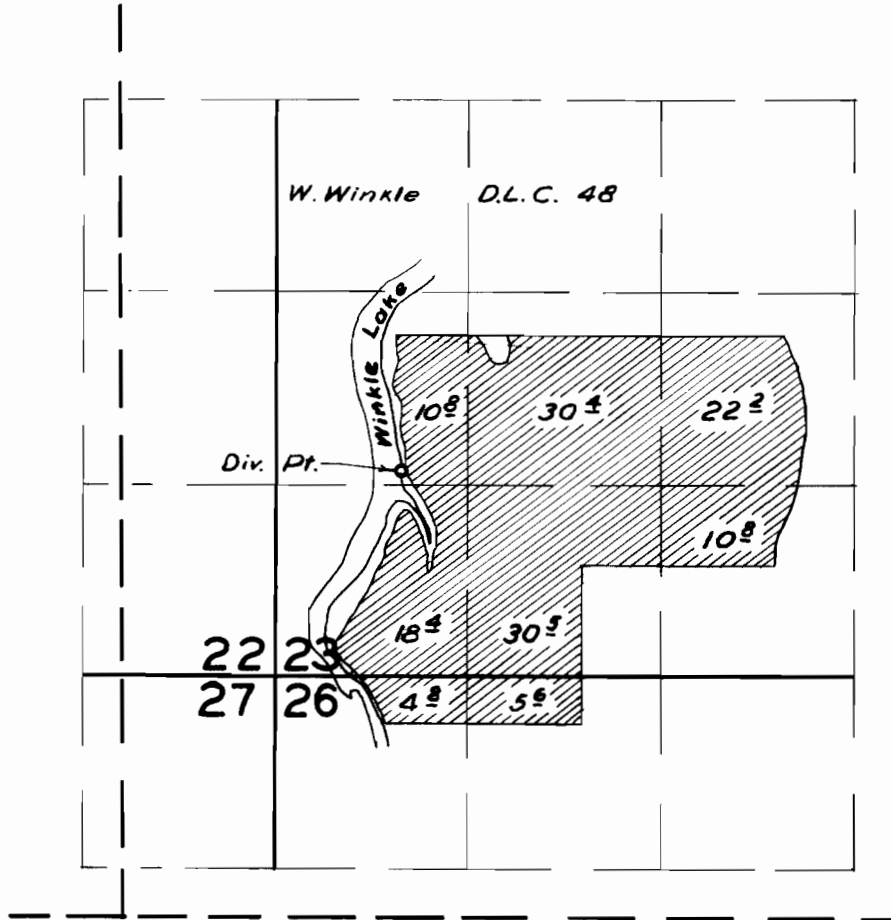

FINAL PROOF SURVEY UNDER

Application No. 28603 Permit No. 22534
IN NAME OF

BOSE BROTHERS

Surveyed 13 Mar. 1959, by T. B. Rich