


T. 1 S. R. 4 E. W.M.

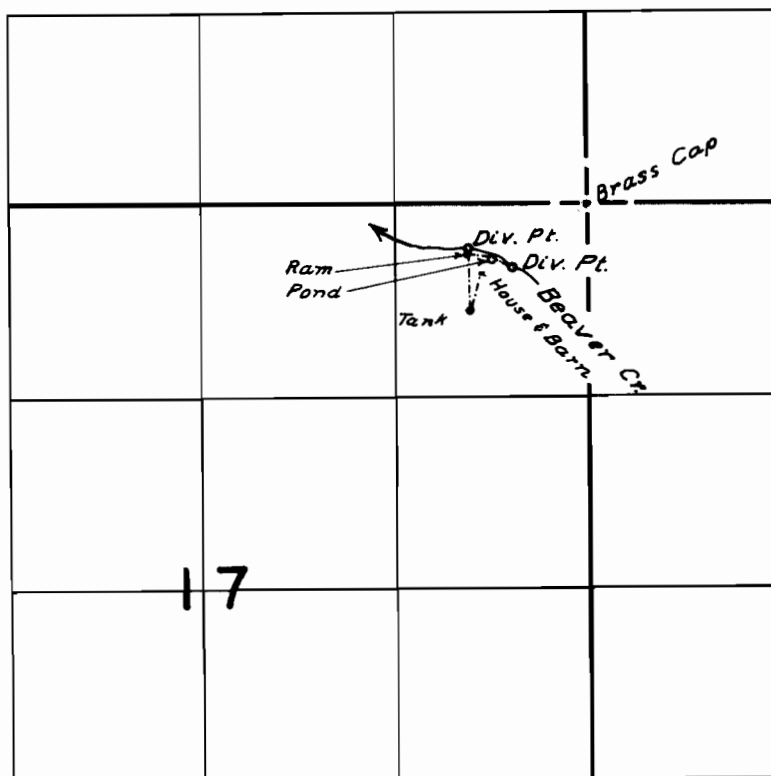

FINAL PROOF SURVEY
UNDER

Application No. 28627 Permit No. 22543
IN NAME OF

Henry F. & Justine F. Tilgner

Surveyed June 3 1959, by C.O. Bartels