


T. 1N. R. 4E. W.M.

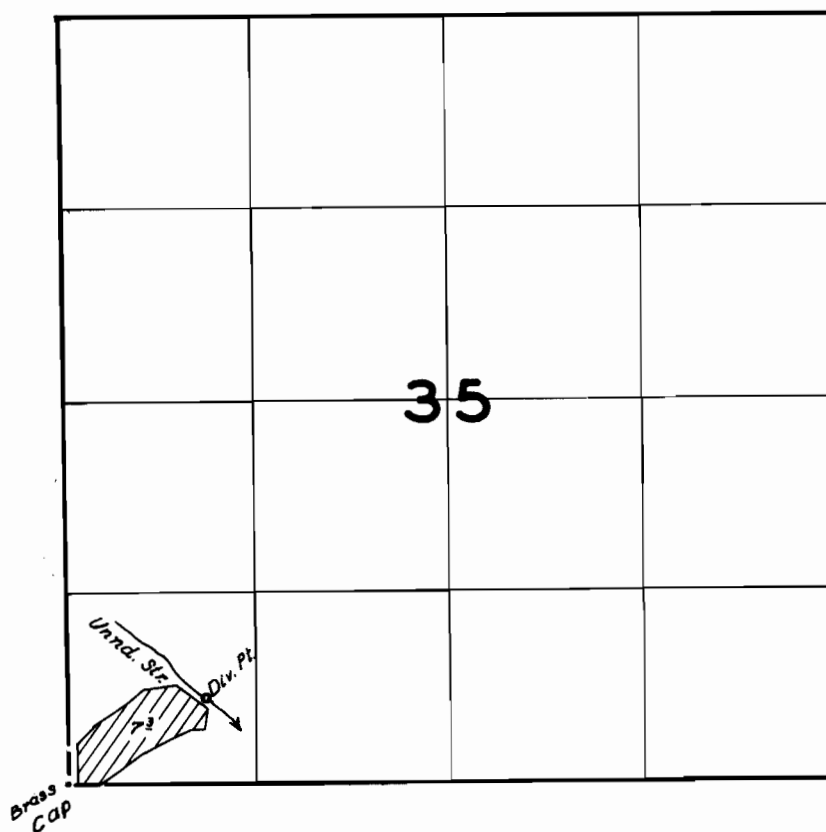

FINAL PROOF SURVEY
UNDER

Application No. 28636 Permit No. 22546
IN NAME OF

Kenneth E. Innis

Surveyed June 1, 1959, by C.O. Bartels