


T. 7N. R. 9W. W.M.

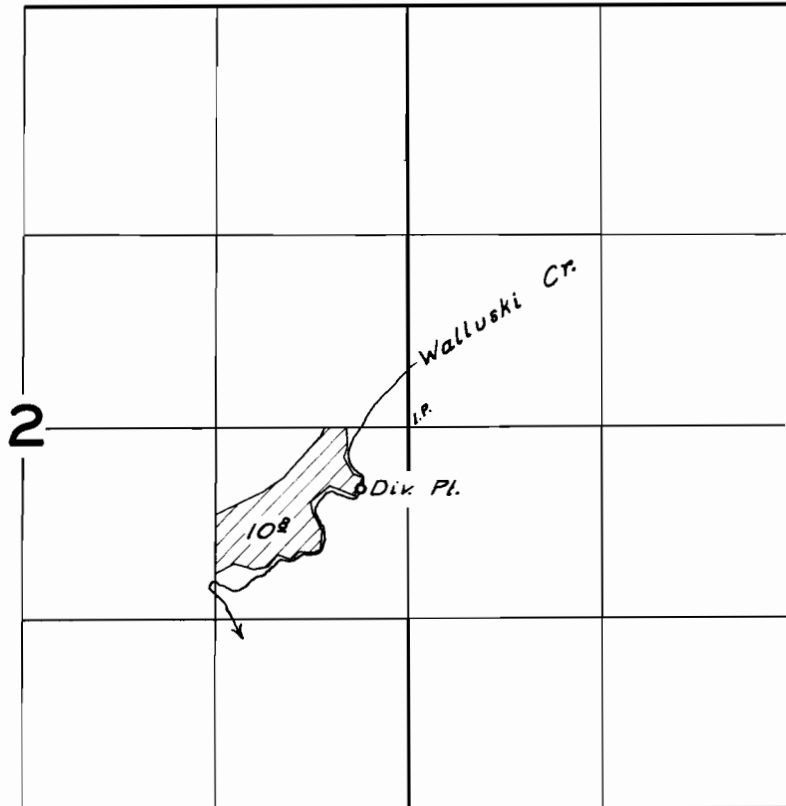

FINAL PROOF SURVEY
UNDER

Application No. 28758... Permit No. 22619...
IN NAME OF

..... *Leonard G. Vernon*

Surveyed *July 2*... 1959, by *C.O. Bartels*.....