


T. 2S. R. 2W. W.M.

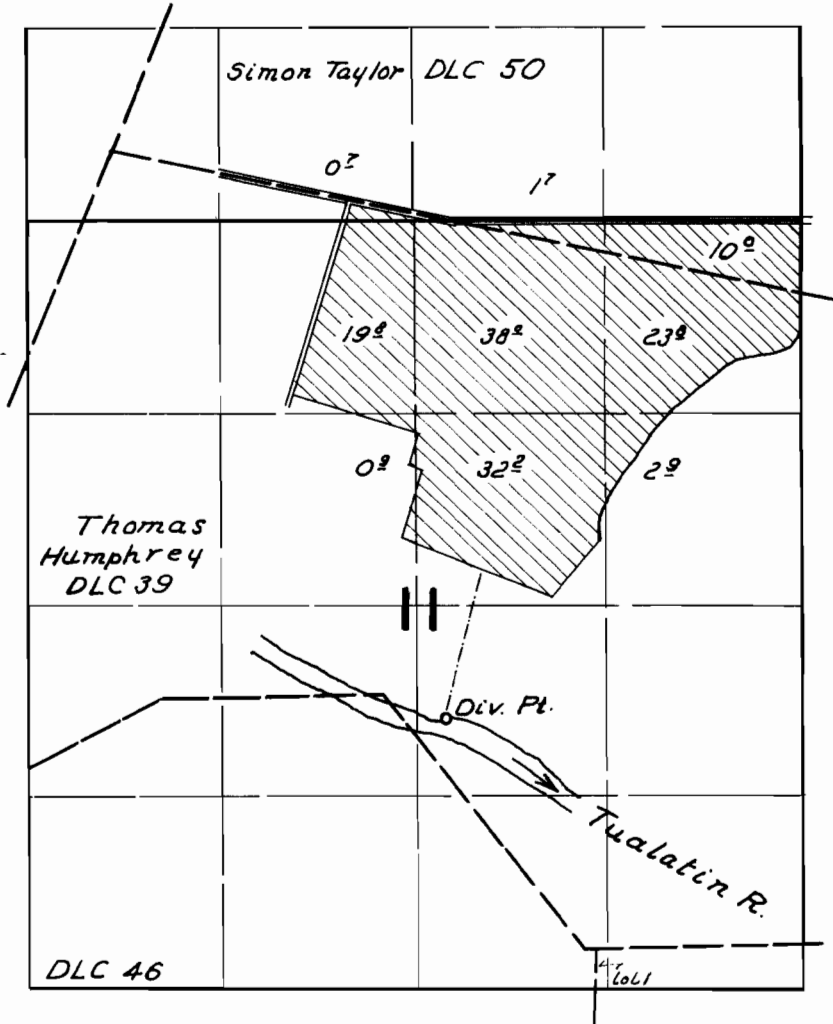

FINAL PROOF SURVEY
UNDER
APPLICATION NO. 28994 PERMIT NO. 22795
IN NAME OF
WALDO B. FLINT
SURVEYED SEPT. 16 1959 BY C.O. BARTELS