


T.13 & 14 S. R.8 W.W.M.

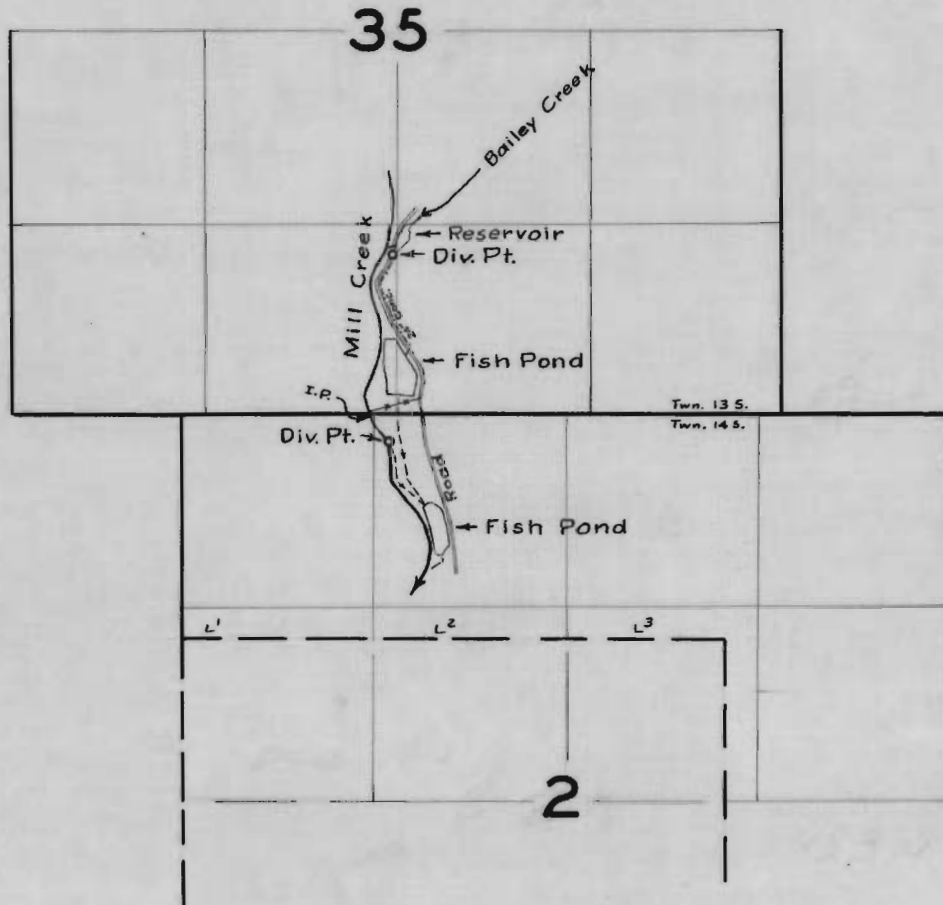

FINAL PROOF SURVEY
UNDER

Application No. 29108 Permit No. 22879
IN NAME OF

BETHEL C. VERNON

Surveyed 16 Mar. 1959, by m. Bish