


T.17S. R.8W.W.M.

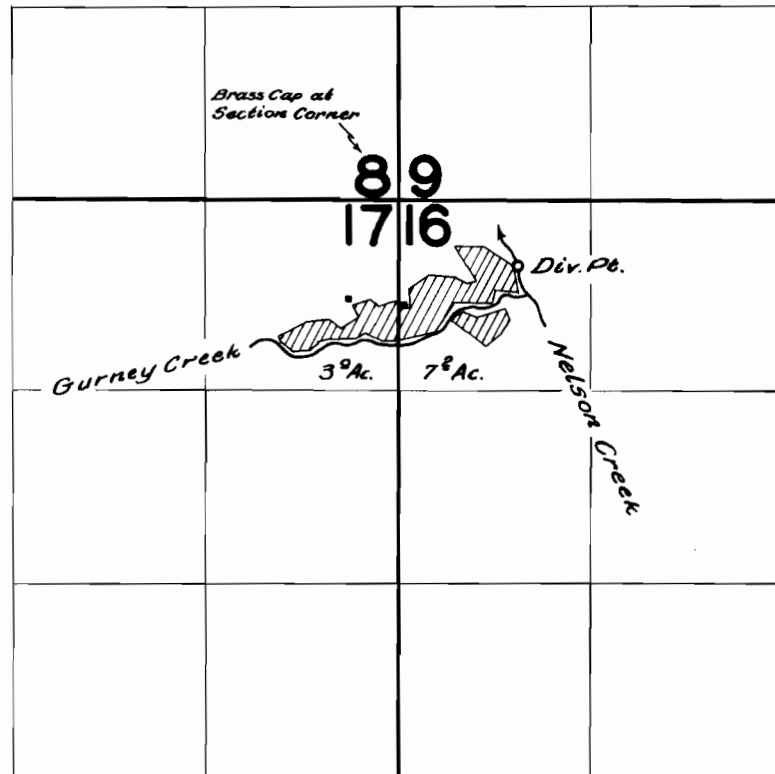

FINAL PROOF SURVEY
UNDER

Application No. 29308. Permit No. 23083
IN NAME OF

.....*Selmer & Marie Thorpe*.....

Surveyed *March 24*, 1959, by *C.D. Barth*.....