


T. 2S. R. 2W. W.M.

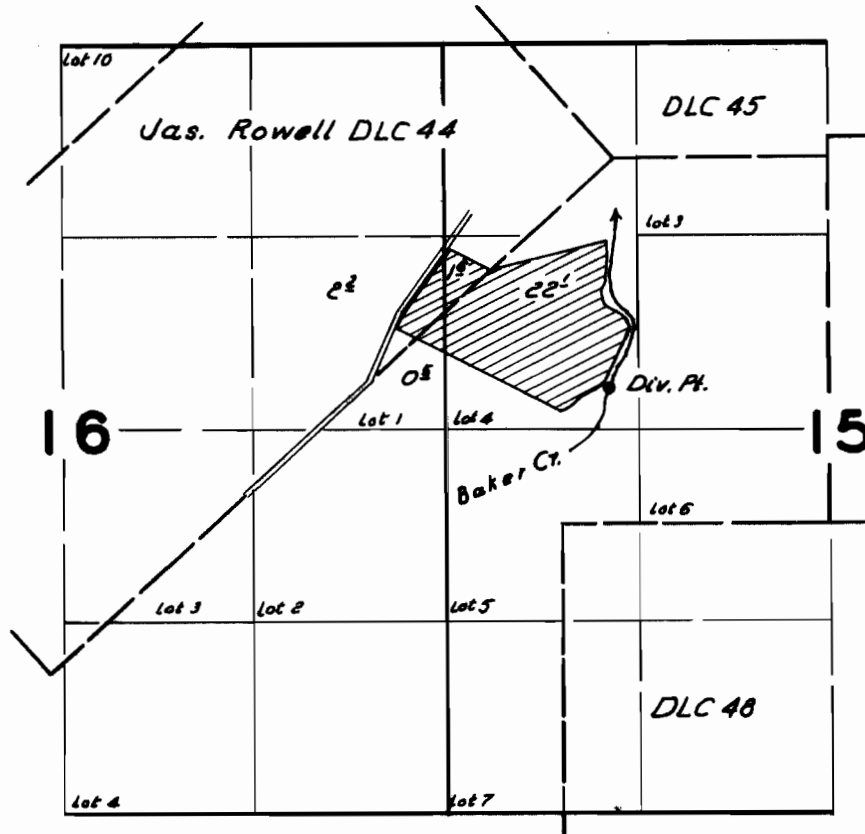

**FINAL PROOF SURVEY**  
UNDER

Application No. ~~23139~~ ..... Permit No. 23157.....  
IN NAME OF

..... *G.E. & Ann Smith* .....

Surveyed *Sept. 16, 1959*, by *C.O. Bartels*.....