


T.15 S.R.8W.W.M.

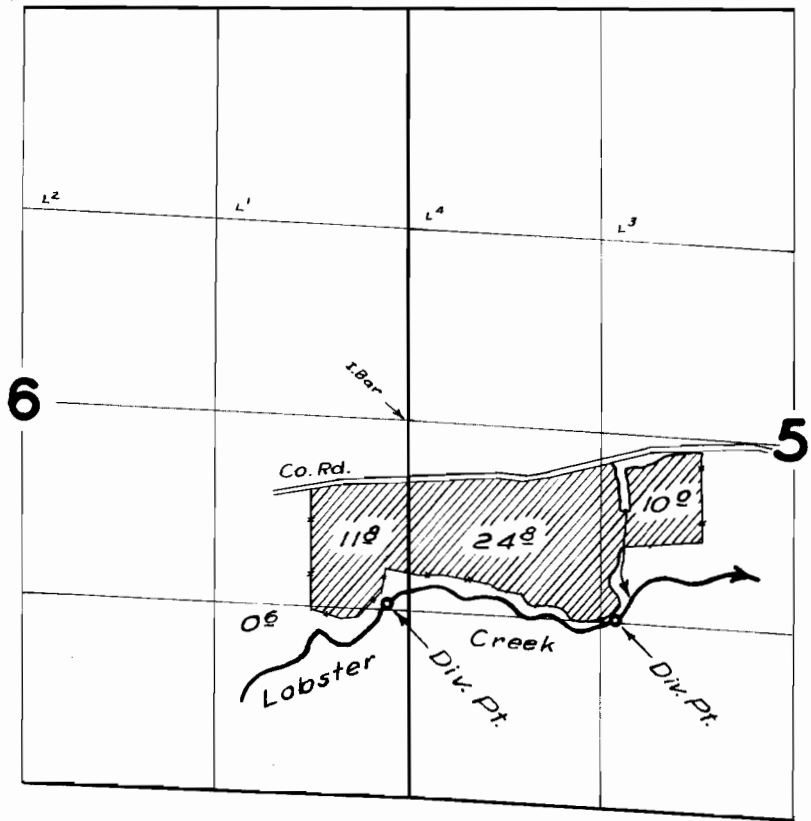

FINAL PROOF SURVEY UNDER

Application No. 29812 ... Permit No. 23512 ...
IN NAME OF

LOBSTER VALLEY FARMS

Surveyed 19 Mar. 1959, by M. Bish