


T. 22 S. R. 8 W. W. M.

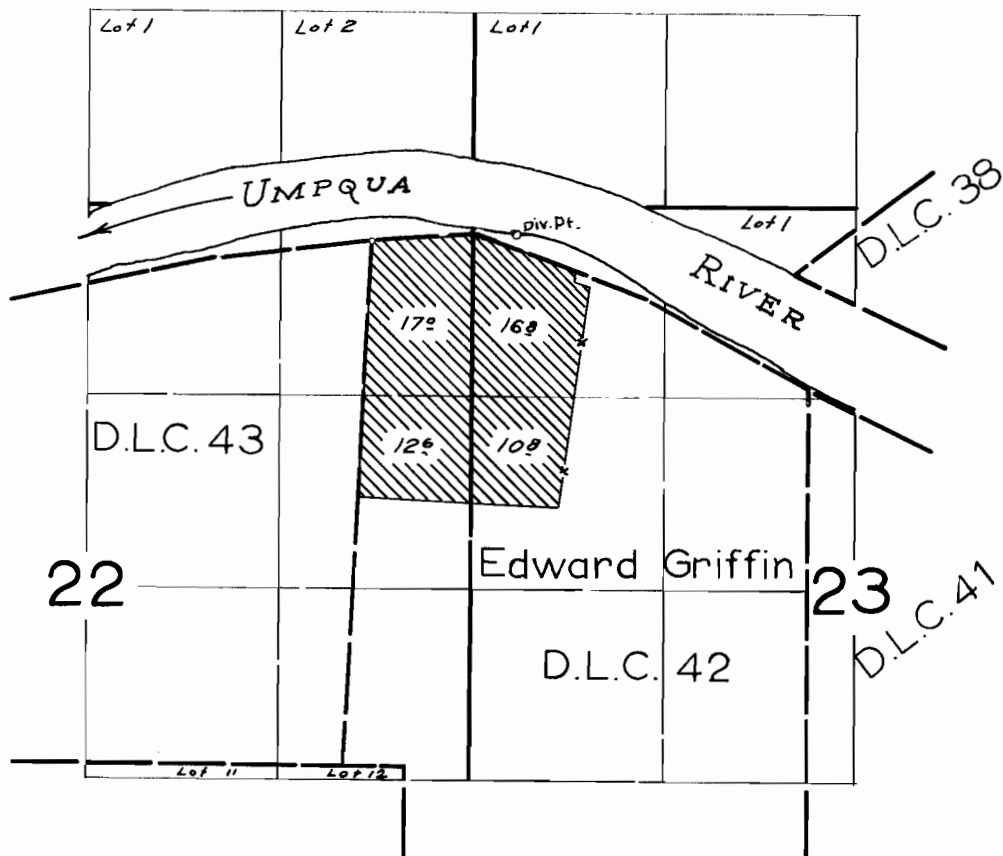

**FINAL PROOF SURVEY**  
UNDER

Application No. 29963 Permit No. 23604  
IN NAME OF

ROSE HENDERER BOWMAN

Surveyed June 18 1959, by *R. Jackson*