


T. 11S. R. 1W. W.M.

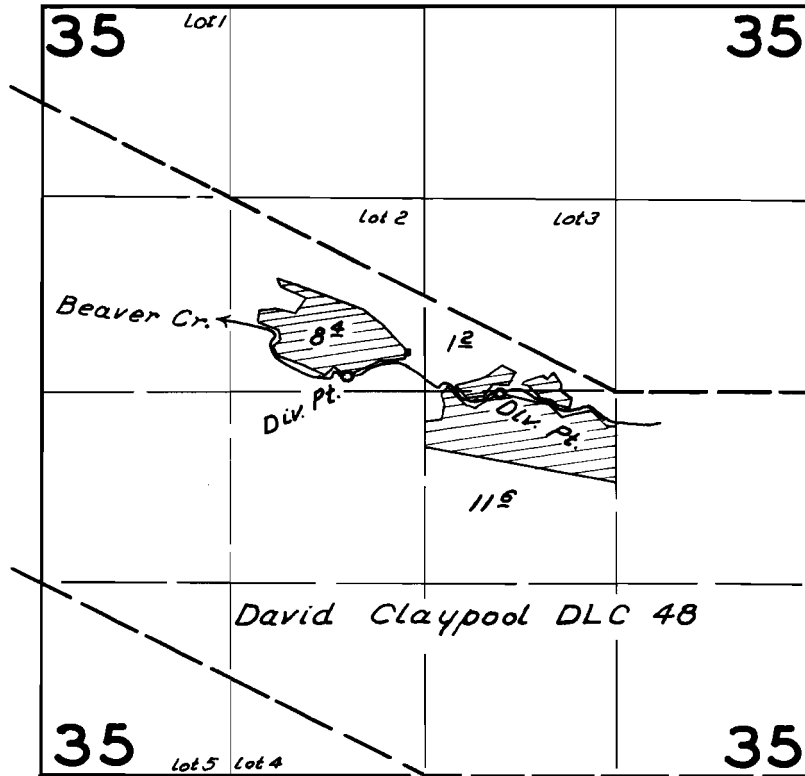

FINAL PLAT OF SURVEY

1959

Acres 30118 23717

Ray & Ella Jean Ackerman

July 30 59 R. H. Jackson