


T.17S. R.6W.W.M.

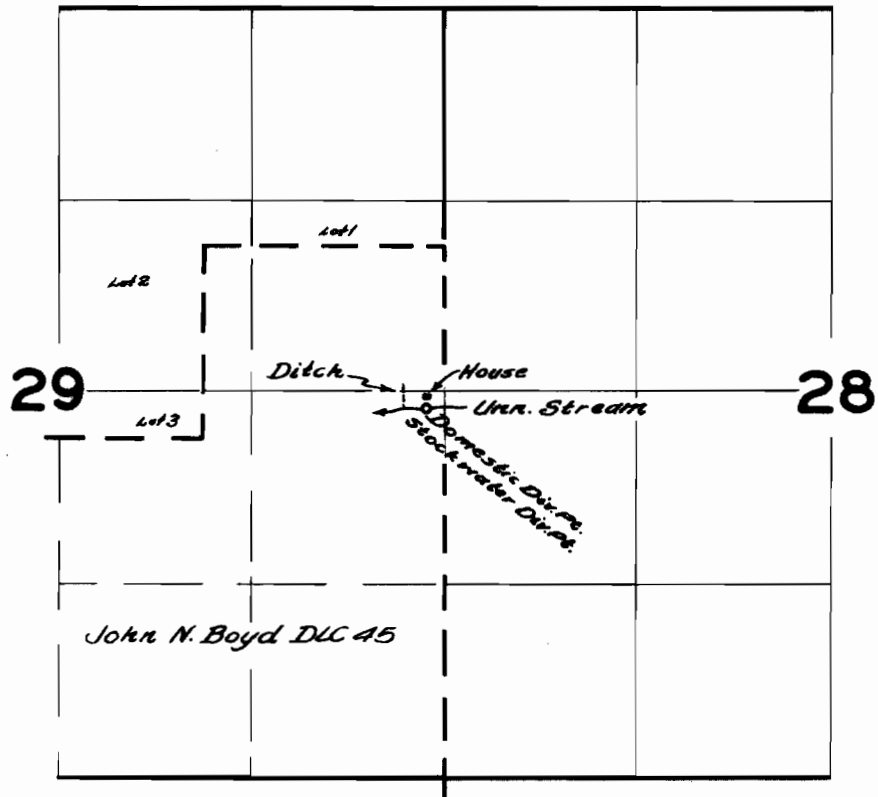

FINAL PROOF SURVEY
UNDER

Application No. 29413 Permit No. 23750
IN NAME OF

TAYLOR V. CLARK

Surveyed March 25 1959, by C.O. Baillie