


T.10 S. R.10 W.W.M.

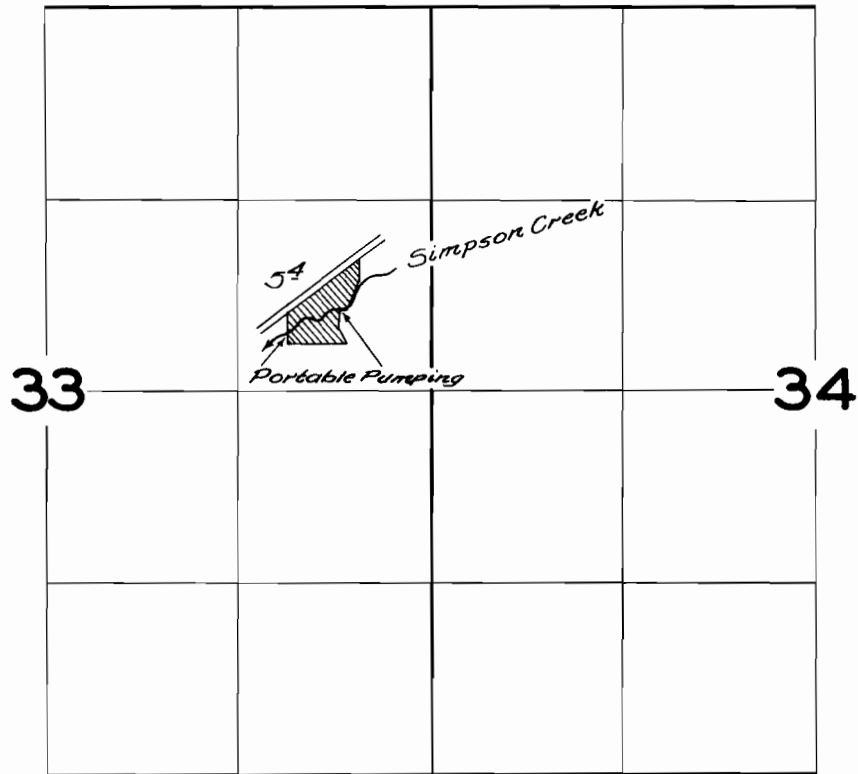

FINAL PROOF SURVEY
UNDER

Application No. 30090 Permit No. 23763
IN NAME OF

Surveyed April 24 1959, by *C. B. Baults*