


T. 1 S. R. 39 E. W.M.

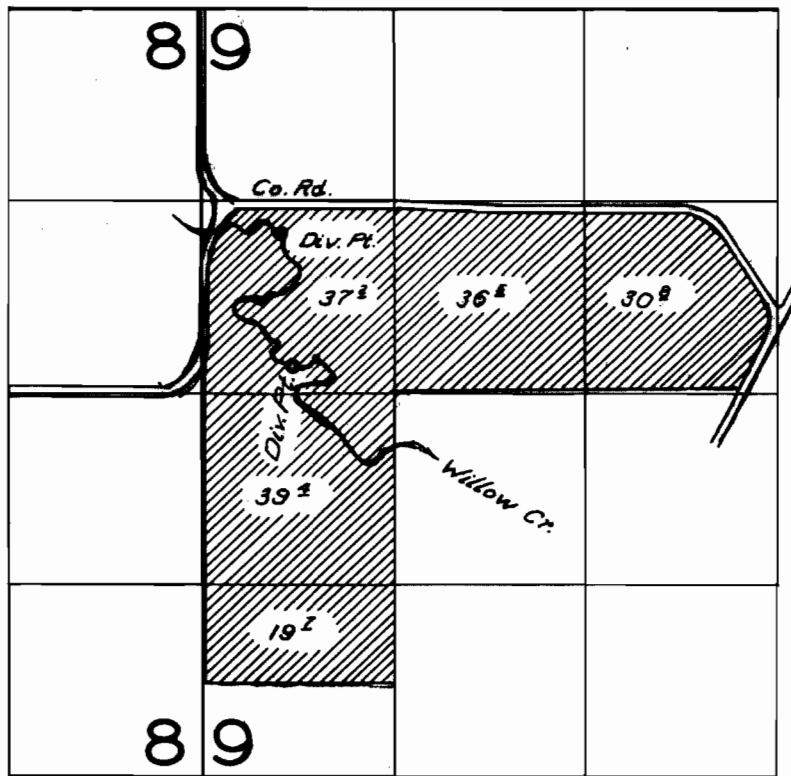

FINAL PROOF SURVEY
UNDER

Application No. 30113 Permit No. 23768
IN NAME OF

Reid Hibberd

Surveyed Aug. 8, 1959, by R. H. Jackson