

T. 36 S., R. 2 W., W.M.

7 8
18 17


S.E. 1/4 OF
N.W. 1/4 SEC. 18



Scale: 1" = 400'

3753'

1.45 ACRES

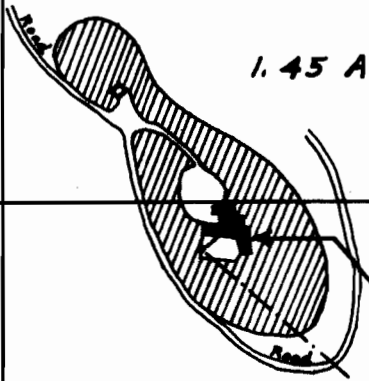

1.55 ACRES
DOMESTIC

18

N.E. 1/4 OF
S.W. 1/4 SEC. 18

PUMP
DIVERSION

WEST

2736'

GOLD RAY DAM

SOUTH

FINAL PROOF SURVEY

UNDER

Application No. 30170 Permit No. 23795

IN NAME OF

John Day

Surveyed March 2, 1960, by D.C. Hendrix