


T.20S.R.47E.W.M.

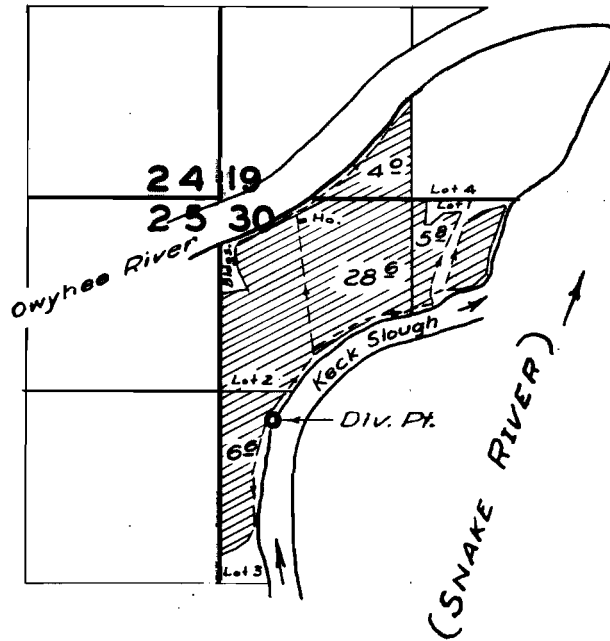

FINAL PROOF SURVEY
UNDER

Application No. 30339 Permit No. 23866
IN NAME OF

A.H. KECK

Surveyed 19 Sept. 1959, by m. B. Bish