


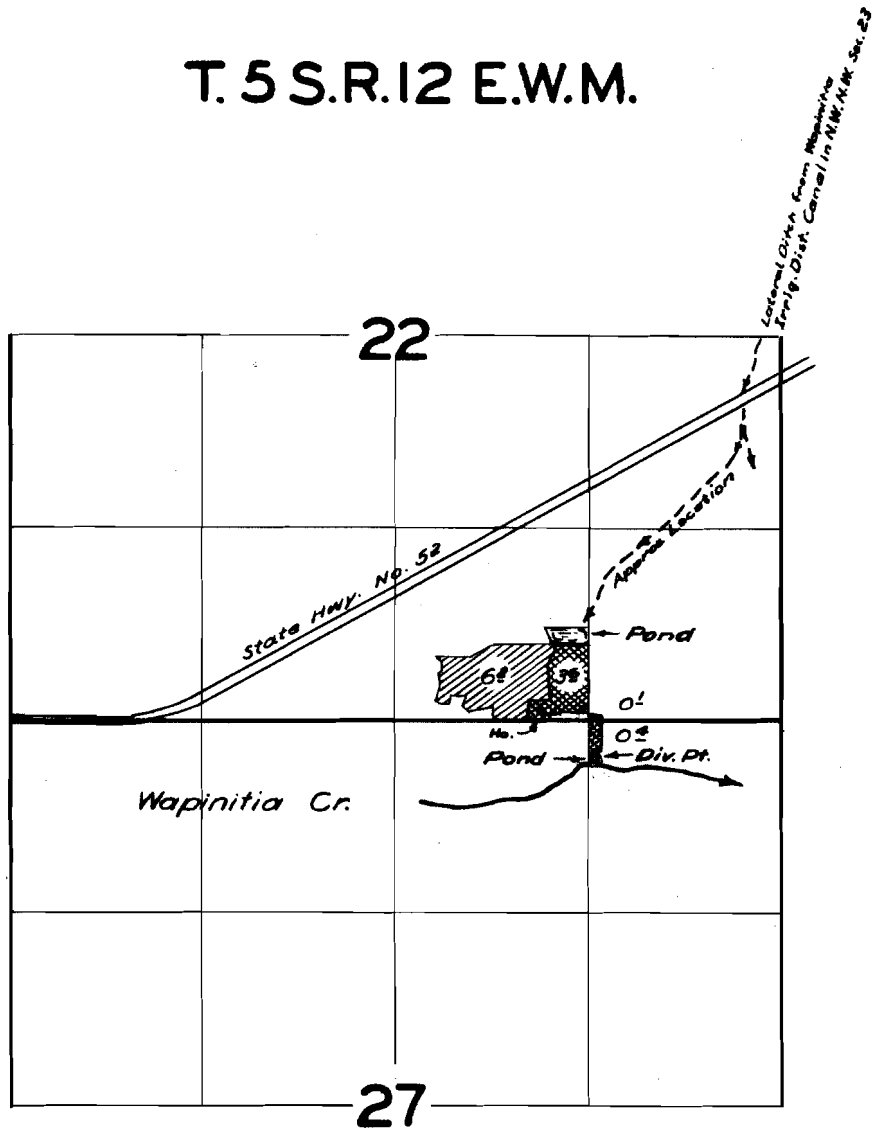

T. 5 S. R. 12 E. W. M.



FINAL PROOF SURVEY
UNDER

Transfer No. D-73 
Application No. 30216 Permit No. 23966 
IN NAME OF

HAROLD L. DYKE & LOIS B. DYKE

Surveyed Nov 16 1959, by M. B. Bish