


T.37S. R.6W.W.M.

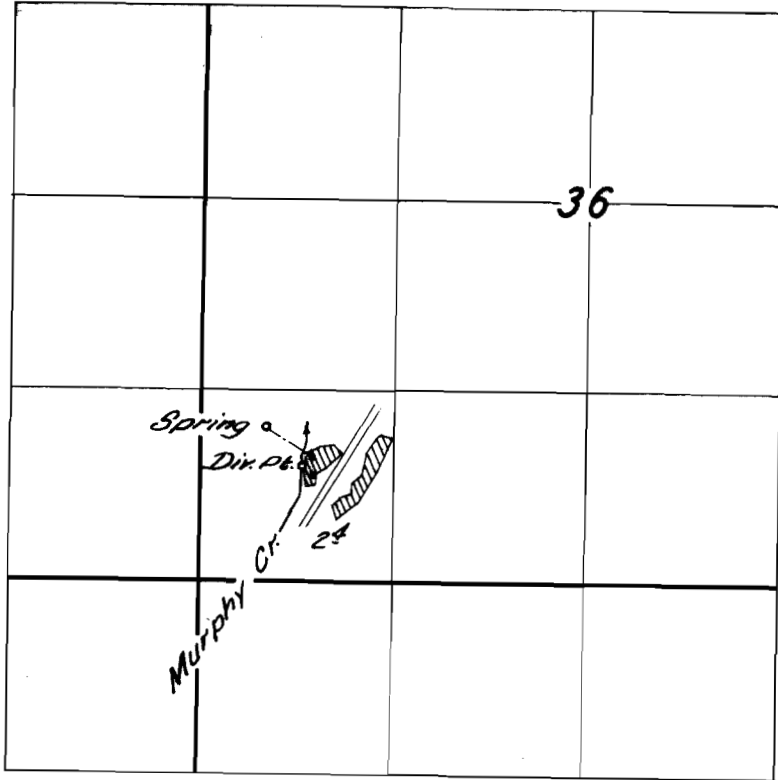

# FINAL PROOF SURVEY

UNDER

Application No. 30269 Permit No. 23999

IN NAME OF

Raymond E. & Lillian M. Amy

Surveyed July 25 1959, by CB Britts