


T. 36 S. R. 6 W. W.M.

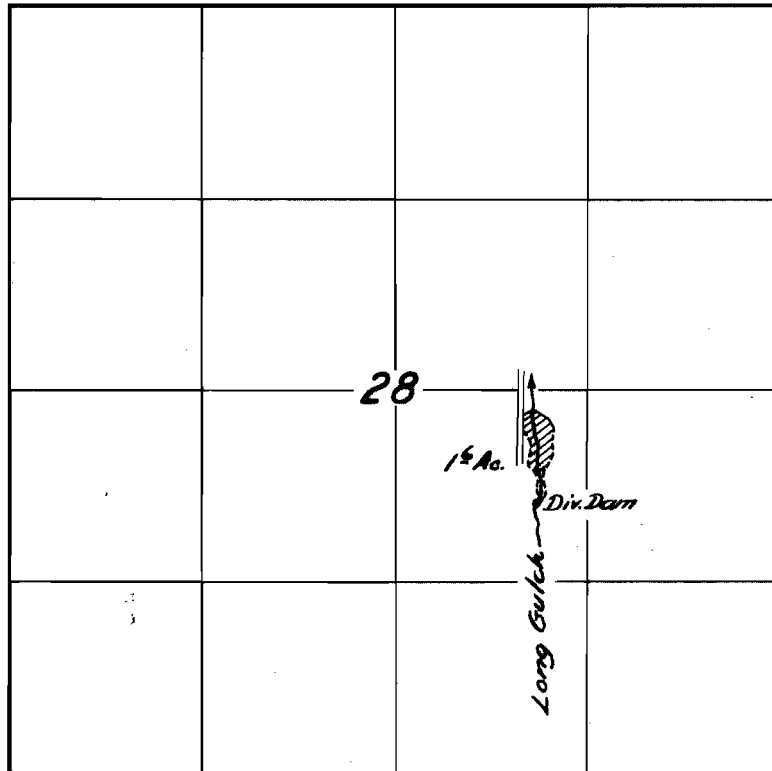

FINAL PROOF SURVEY

UNDER

Application No. 30494 Permit No. 24016

IN NAME OF

R. S. Long

Surveyed July 15 1959, by C. C. Bartlett