


T. 2S. R. 1W. W.M.

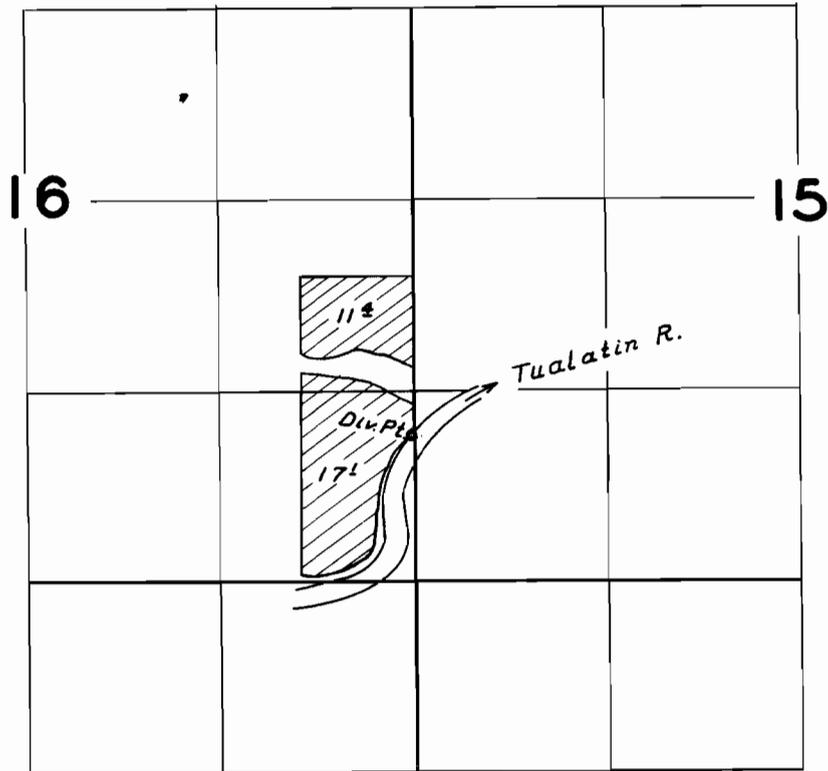

FINAL PROOF SURVEY
UNDER

Application No. 30561..... Permit No. 24078...
IN NAME OF

.....*Mrs. Etta Southard*.....

Surveyed *Sept. 14, 1959*, by *C.O. Bartels*.....